




LOCAL AREA

HIGHWAY MAP

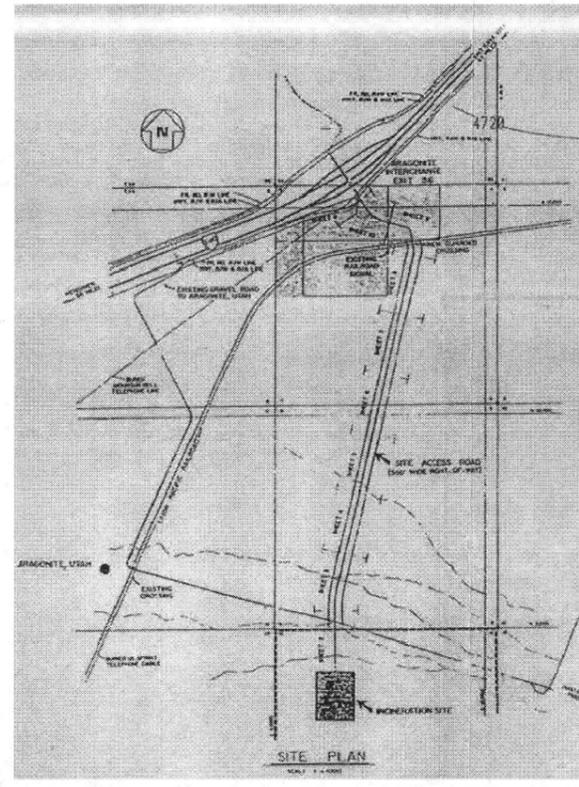

NOTES:

- TOPOGRAPHY SHOWN WAS TAKEN FROM U.S.G.S. QUADRANGLE "HASTINGS PASS, UTAH, 1973".
- NOT IN 100 YEAR FLOOD PLAIN. HIGHEST RECORDED LEVEL OF GREAT SALT LAKE, ELEVATION 4,217 FEET MEAN SEA LEVEL.
- BASIS OF BEARINGS IS EAST FROM NORTHWEST CORNER OF SECTION 16, T.1 S., R. 10 W., S.L.B.&M. TO THE NORTHEAST CORNER OF SAID SECTION 16.
- BENCHMARK IS APPROXIMATE U.S.G.S. DATUM FROM NORTHWEST CORNER OF SAID SECTION 16.
- PLANT ELEVATION DATUM 100'-0" EQUALS U.S.G.S. ELEVATION DATUM 4,682'-0".
- FOR SURVEY CONTROL MONUMENT DATA, SEE R&M DRAWING NUMBER 8936-1.
- LAND DESCRIPTION:
A TRACT OF LAND LYING IN TOOELE COUNTY, STATE OF UTAH, SECTION 16, TOWNSHIP ONE (1) SOUTH, RANGE TEN WEST, SALT LAKE MERIDIAN AND BASE LINE, CONTAINING 640 ACRES MORE OR LESS, ACCORDING TO THE UNITED STATES SURVEY.

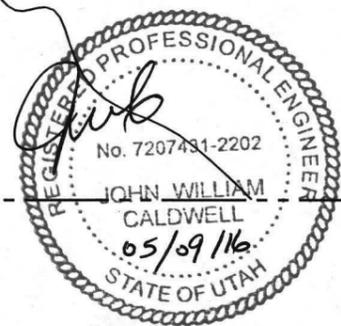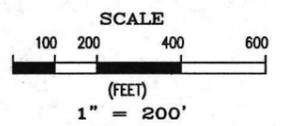

N.W. COR. SEC. 16, T.1S., R.10W., S.L.B. & M.

SECTION 16

S.W. COR. SEC. 16, T.1S., R.10W., S.L.B. & M.

REVISIONS									
NO	DESCRIPTION	DATE	BY	CHK	ELEC	MECH	STR	PROJ MGR	NO
1	APPROVED FOR CONSTRUCTION	7-21-89							
2	ADDED MONUMENTS	1-5-90	RLJ					JV	
3	AS BUILT	07-01-91	DCP						
4	ADDED NEW BLDGS & TITLE BLOCK	05-06-16	MM						

REVISIONS									
NO	DESCRIPTION	DATE	BY	CHK	ELEC	MECH	STR	PROJ MGR	NO

REFERENCE DRAWINGS	
DRAWING NO	TITLE
D-034-M-002	PLANT PLOT PLAN
8936-1 (R&M)	OFF SITE FACILITIES

REGISTERED PROFESSIONAL ENGINEER
DATE: _____

APPROVALS	
BY	DATE

CURRENT DRAWING STATUS	
BY	DATE



TITLE
UTAH ENVIRONMENTAL SERVICE CENTER
INCINERATION PLANT FOR INDUSTRIAL WASTES
SITE PLAN

FOR TOOELE SITE		CAD DISK FILE	MK966
SCALE 1" = 200'	JOB NO	APTUS DWG NO	REV
		D-034-M-001	3