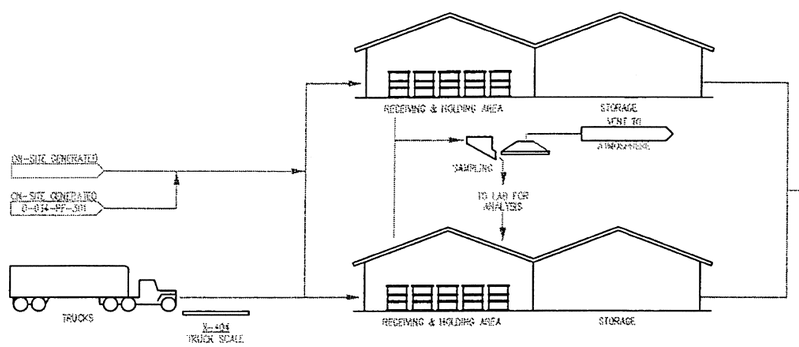

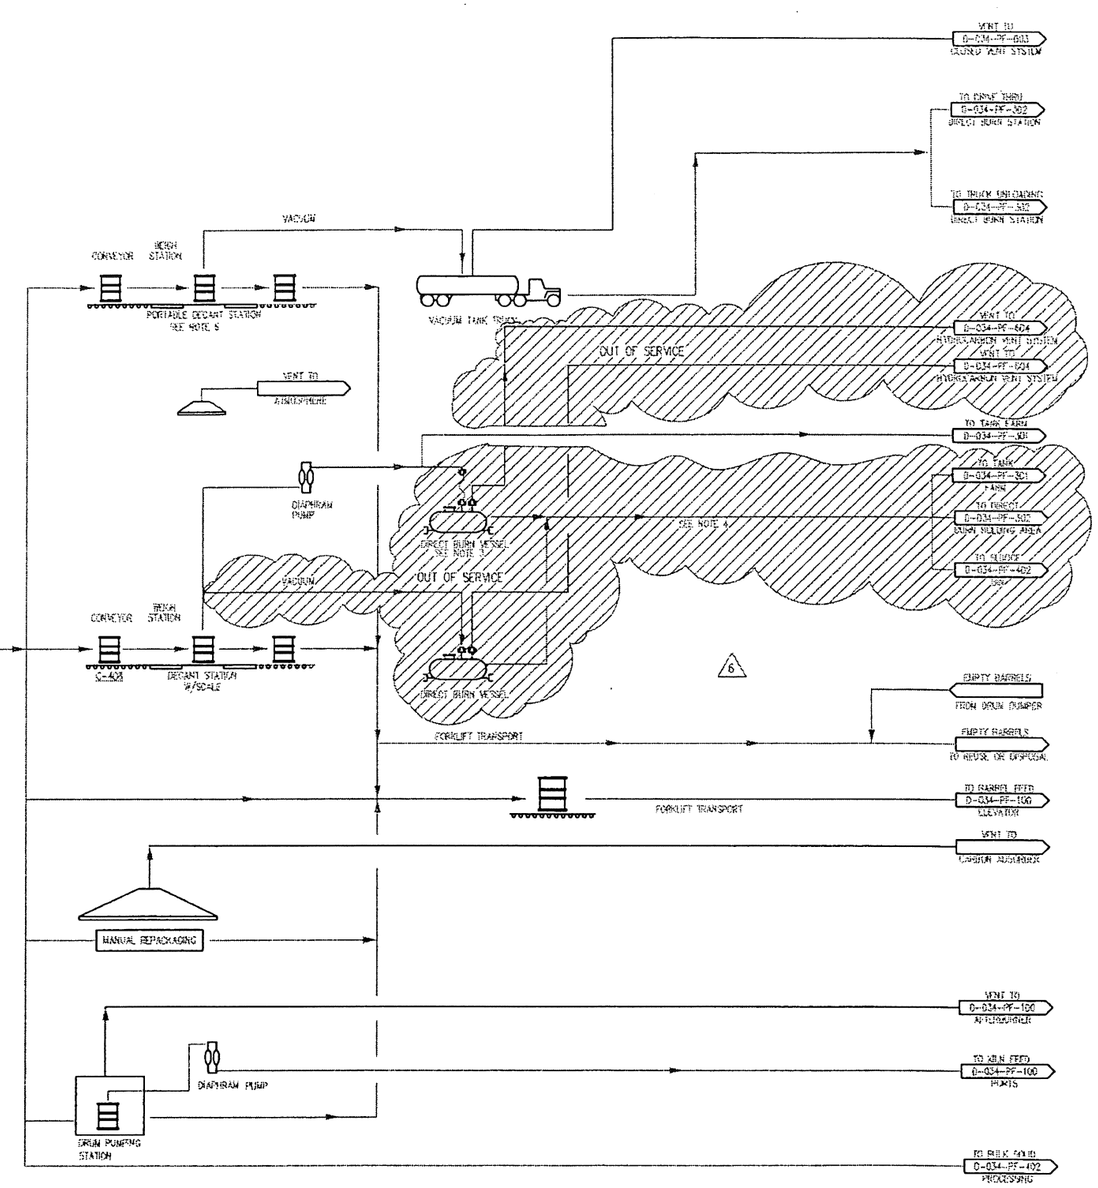

NOTES:

1. BARREL HANDLING EQUIP. TO BE DESIGNED FOR CONTAINERS RANGING FROM 5 GAL. CANS TO 55 GAL. OVERPACKS. ALSO, MARINO BAGS MAY BE HANDLED IN WAREHOUSE, BULK SOLIDS SYSTEM OR MANUAL REPACKAGING.
2. DESIGN CONVEYORS AND BARREL HANDLING FOR 1200 LB. MAXIMUM CONTAINER WEIGHT.
3. DIRECT BURN VESSELS CAPACITY "660 GALLONS, NOMINAL".
4. DECANTED LIQUIDS MAY BE SHIPPED BY DIRECT PUMPING, NITROGEN PRESSURIZING OF TRANSPORTABLE CONTAINER OR BY PHYSICALLY MOVING THE TRUCK/CONTAINER.
5. VENTILATION NOT REQUIRED OUTSIDE OF BUILDINGS.
6. WEIGHING MAY BE DONE AT DECANT STATION OR IN ANOTHER LOCATION.

LICENSED PROFESSIONAL ENGINEER
KARL D. LIBSCH
No. 334380-2202
7/12/06
STATE OF UTAH

REVISIONS

NO	DESCRIPTION	DATE	BY	CHK	ELEC	MECH	STR	PROJ MGR
0	AS BUILT	02-02-91	DCP	TB				JV
1	AS BUILT	10-15-91	DCP					CHW
2	AS BUILT	12-07-93	DCP			JV		
3	ADDED WASTE FROM PF-301, REPACK WITHOUT DECANT	10-15-02	KL	LC				
4	ADDED DECANT TO TANKER, GENERAL REVISION	04-16-03	KL					
5	ADDED DRUM PUMPING STATION	11-03-03	KL					

REVISIONS

NO	DESCRIPTION	DATE	BY	CHK	ELEC	MECH	STR	PROJ MGR
6	ADDED DRUM DUMPER RETURN, DECANT DBV OUT OF SERVICE	07-12-06	KL					

REFERENCE DRAWINGS

DRAWING NO	TITLE

REGISTERED PROFESSIONAL ENGINEER
DATE: _____

APPROVALS

	BY	DATE
DRAWN	DCP	2-07-93
CHECKED		
LEAD ENG.		
ELEC CHECK		
MECH CHECK		
STRUCT CHECK		
PROJECT ENG		
PROJECT MGR		

CURRENT DRAWING STATUS

	BY	DATE
PRELIMINARY OR PLANNING		
APPROVED FOR FINAL DESIGN		
APPROVED FOR QUOTE/PURCH		
APPROVED FOR CONSTRUCTION		
AS-BUILT	CHW	12-08-93

CleanHarbors
ARAGONITE LLC

TITLE
UTAH ENVIRONMENTAL SERVICE CENTER
INCINERATION PLANT FOR INDUSTRIAL WASTES
PROCESS FLOW DIAGRAM – BARREL HANDLING

FOR TOOELE SITE | CAD DISK FILE MA063AF

SCALE NONE | JOB NO | ENG. DWG NO | APTUS DWG NO D-034-PF-401 | REV 6