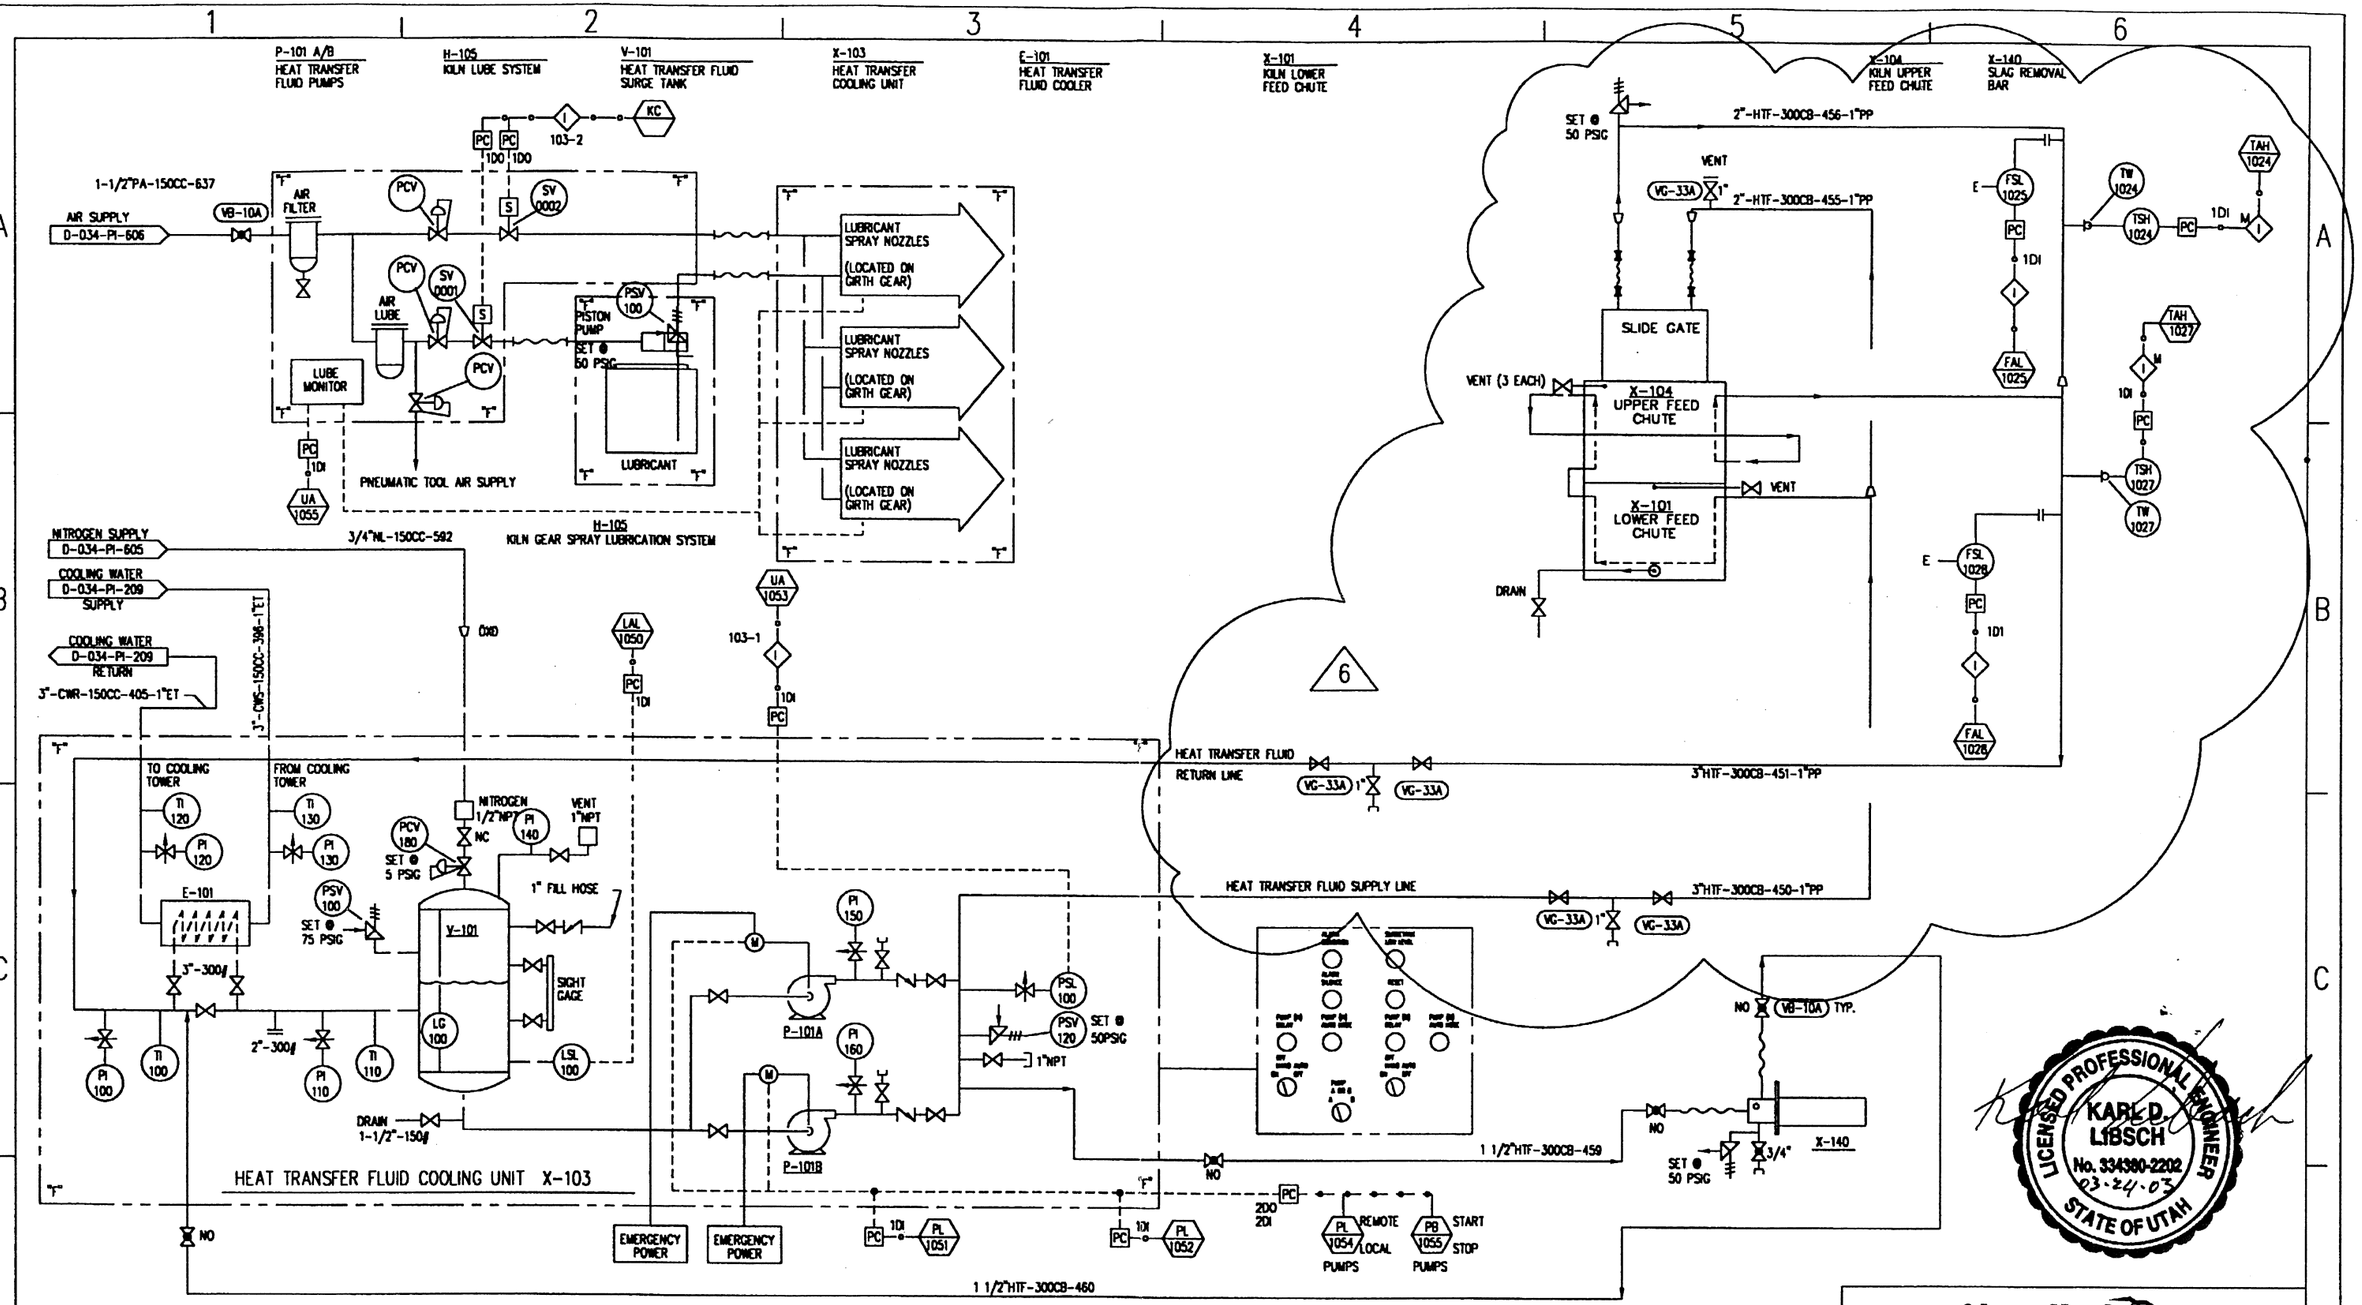

INTERLOCK

DESCRIPTION	
M	MASTER INTERLOCK SYSTEM
103-01	ALARM WHEN SELECTED PUMP MOTOR STOPS AND BACKUP IS STARTED BY VENDOR CONTROL PANEL LOGIC.
103-2	LUBRICATOR SEQUENCE CONTROL

REVISIONS

NO	DESCRIPTION	DATE	BY	CHK	ELEC	MECH	STR	PROJ MGR
0	ISSUED FOR CONSTRUCTION	7-7-89	MU	IRB				JV
1	AS BUILT	06-28-91	DCP					CHW
2	AS BUILT UDATE	12-08-93	DCP					
3	ADDED X-140 & RELATED PIPING	9-16-99	GVC					
	REMOVED SMILEY							
4	ADDED 2 ISOLATION VALVES	11-16-00	GVC					
5	BYPASSED LOWER FEED CHUTE	05-09-02	KL					
6	REPIPED UPPER AND LOWER FEED CHUTE	03-24-03	KL					

REFERENCE DRAWINGS

DRAWING NO	TITLE

REGISTERED PROFESSIONAL ENGINEER
DATE:

APPROVALS

	BY	DATE
DRAWN		
CHECKED		
LEAD ENG.		
ELEC. CHECK		
MECH. CHECK		
STRUCT. CHECK		
PROJECT ENG		
PROJECT MGR		

CURRENT DRAWING STATUS

	BY	DATE
PRELIMINARY OR PLANNING		
APPROVED FOR FINAL DESIGN		
APPROVED FOR QUOTE/PURCH		
APPROVED FOR CONSTRUCTION		
AS-BUILT		

CleanHarbors
ARAPAHOE, LLC

TITLE
UTAH ENVIRONMENTAL SERVICE CENTER
INCINERATION PLANT FOR INDUSTRIAL WASTES
P&ID KILN MISCELLANEOUS SYSTEMS

FOR TOOELE SITE | CAD DISK FILE IH771P
SCALE NONE | JOB NO | ENGL DWG NO | APTUS DWG NO D-034-PI-103 | REV 6

LICENSED PROFESSIONAL ENGINEER
KARL D. LIBSCH
No. 334380-2202
03-24-03
STATE OF UTAH