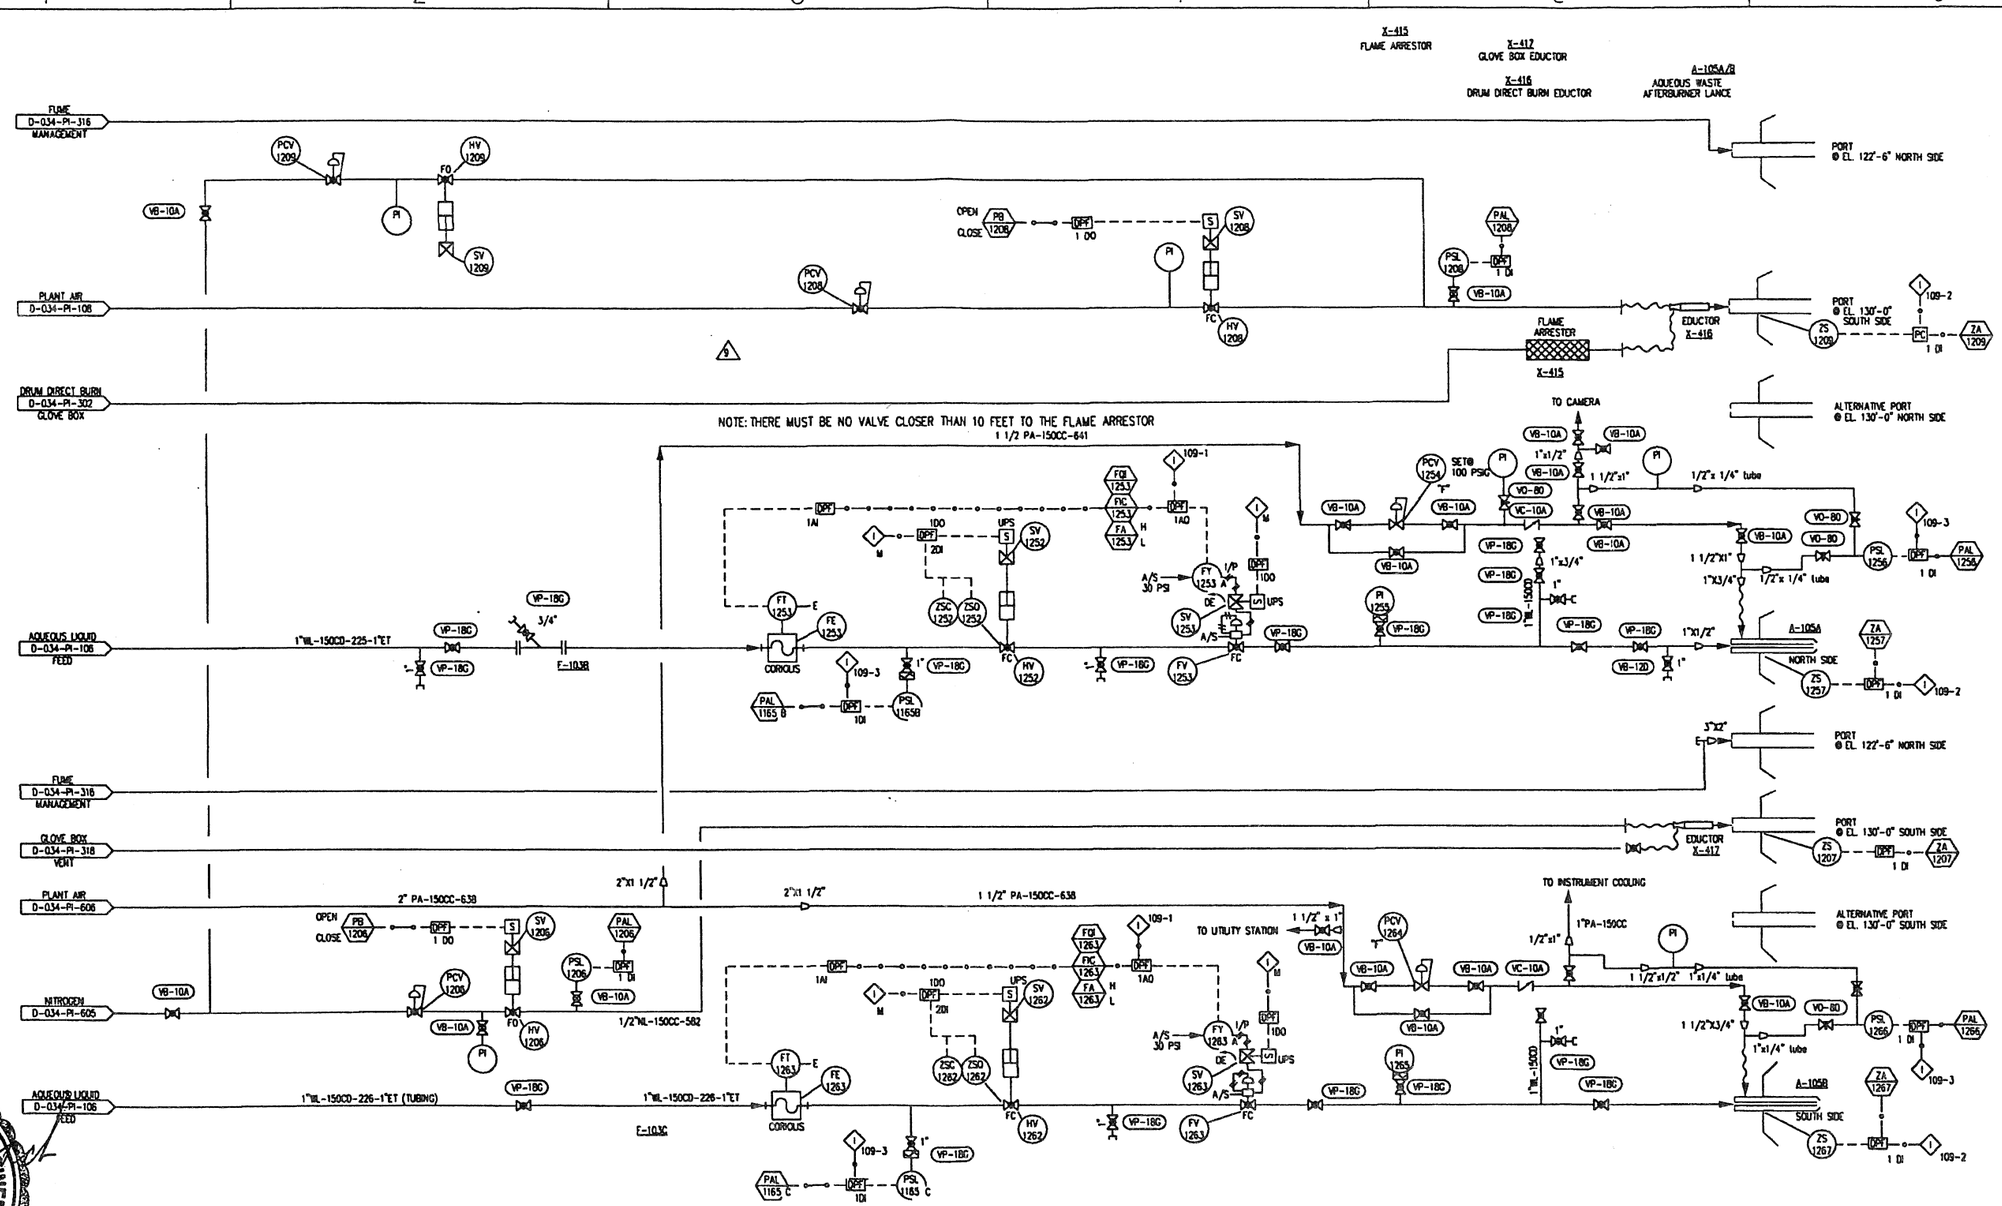

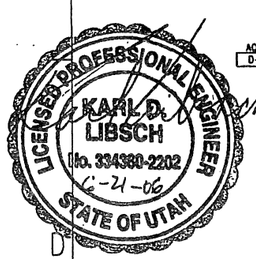

INTERLOCK DESCRIPTION

M MASTER INTERLOCK SYSTEM
109-1 VALVE CLOSED OR MIN FIRE BEFORE BLOCK VALVE CAN BE OPENED.
109-2 LANCE IN POSITION BEFORE VALVE CAN OPEN.
109-3 MINIMUM PRESSURE REQUIRED TO OPERATE FEED LINE

REVISIONS

NO	DESCRIPTION	DATE	BY	CHK		ENG MGR
0	ISSUED FOR CONSTRUCTION	07-07-89	MU	IRB		JV
1	REMOVED H INPUTS, ADD SOFTWARE	09-27-90	PSH	FJM		JV
2	AS BUILT	06-27-91	DCP	JV		CHW
3	AS BUILT	10-15-91	DCP			CHW
4	AS BUILT	12-07-93	DCP			

REVISIONS

NO	DESCRIPTION	DATE	BY	CHK		ENG MGR
5	TO CORRECT DRAFTING ERRORS & AS BUILT F.M.	04-21-98	CRM			
6	MODIFIED COMPRESSED GAS FEED AND MISC CORR	06-19-03	LCC			
7	ADDED DRUM DIRECT BURN GLOVE BOX	11-4-03	KL			
8	ADDED PORT ORIENTATION	11-13-03	KL			
9	REMOVED AQUEOUS STRAINERS, CORRECTIONS	6-14-06	KL			

APPROVALS

	BY	DATE
DRAWN	DRM	04-21-98
CHECKED		
ELEC		
MECH		
STRUCT		
PROJECT ENG		
ENGINEERING MGR		
AS BUILT		

REGISTERED PROFESSIONAL ENGINEER
DATE: _____

CleanHarbors
ARAGONITE LLC

THIS DRAWING IS THE PROPERTY OF CLEAN HARBORS ARAGONITE, LLC
ANY INFORMATION CONTAINED HEREON MAY NOT BE COPIED OR USED WITHOUT WRITTEN PERMISSION OF OWNER.

TITLE
UTAH ENVIRONMENTAL SERVICE CENTER
INCINERATION PLANT FOR INDUSTRIAL WASTES
P&ID AFTERBURNER CONTROLS, SHEET 3

FOR	CAD NO.	
TOOELE SITE	11583W	
SCALE / JOB NO	APTUS DWG NO	REV
	D-034-PI-109	9