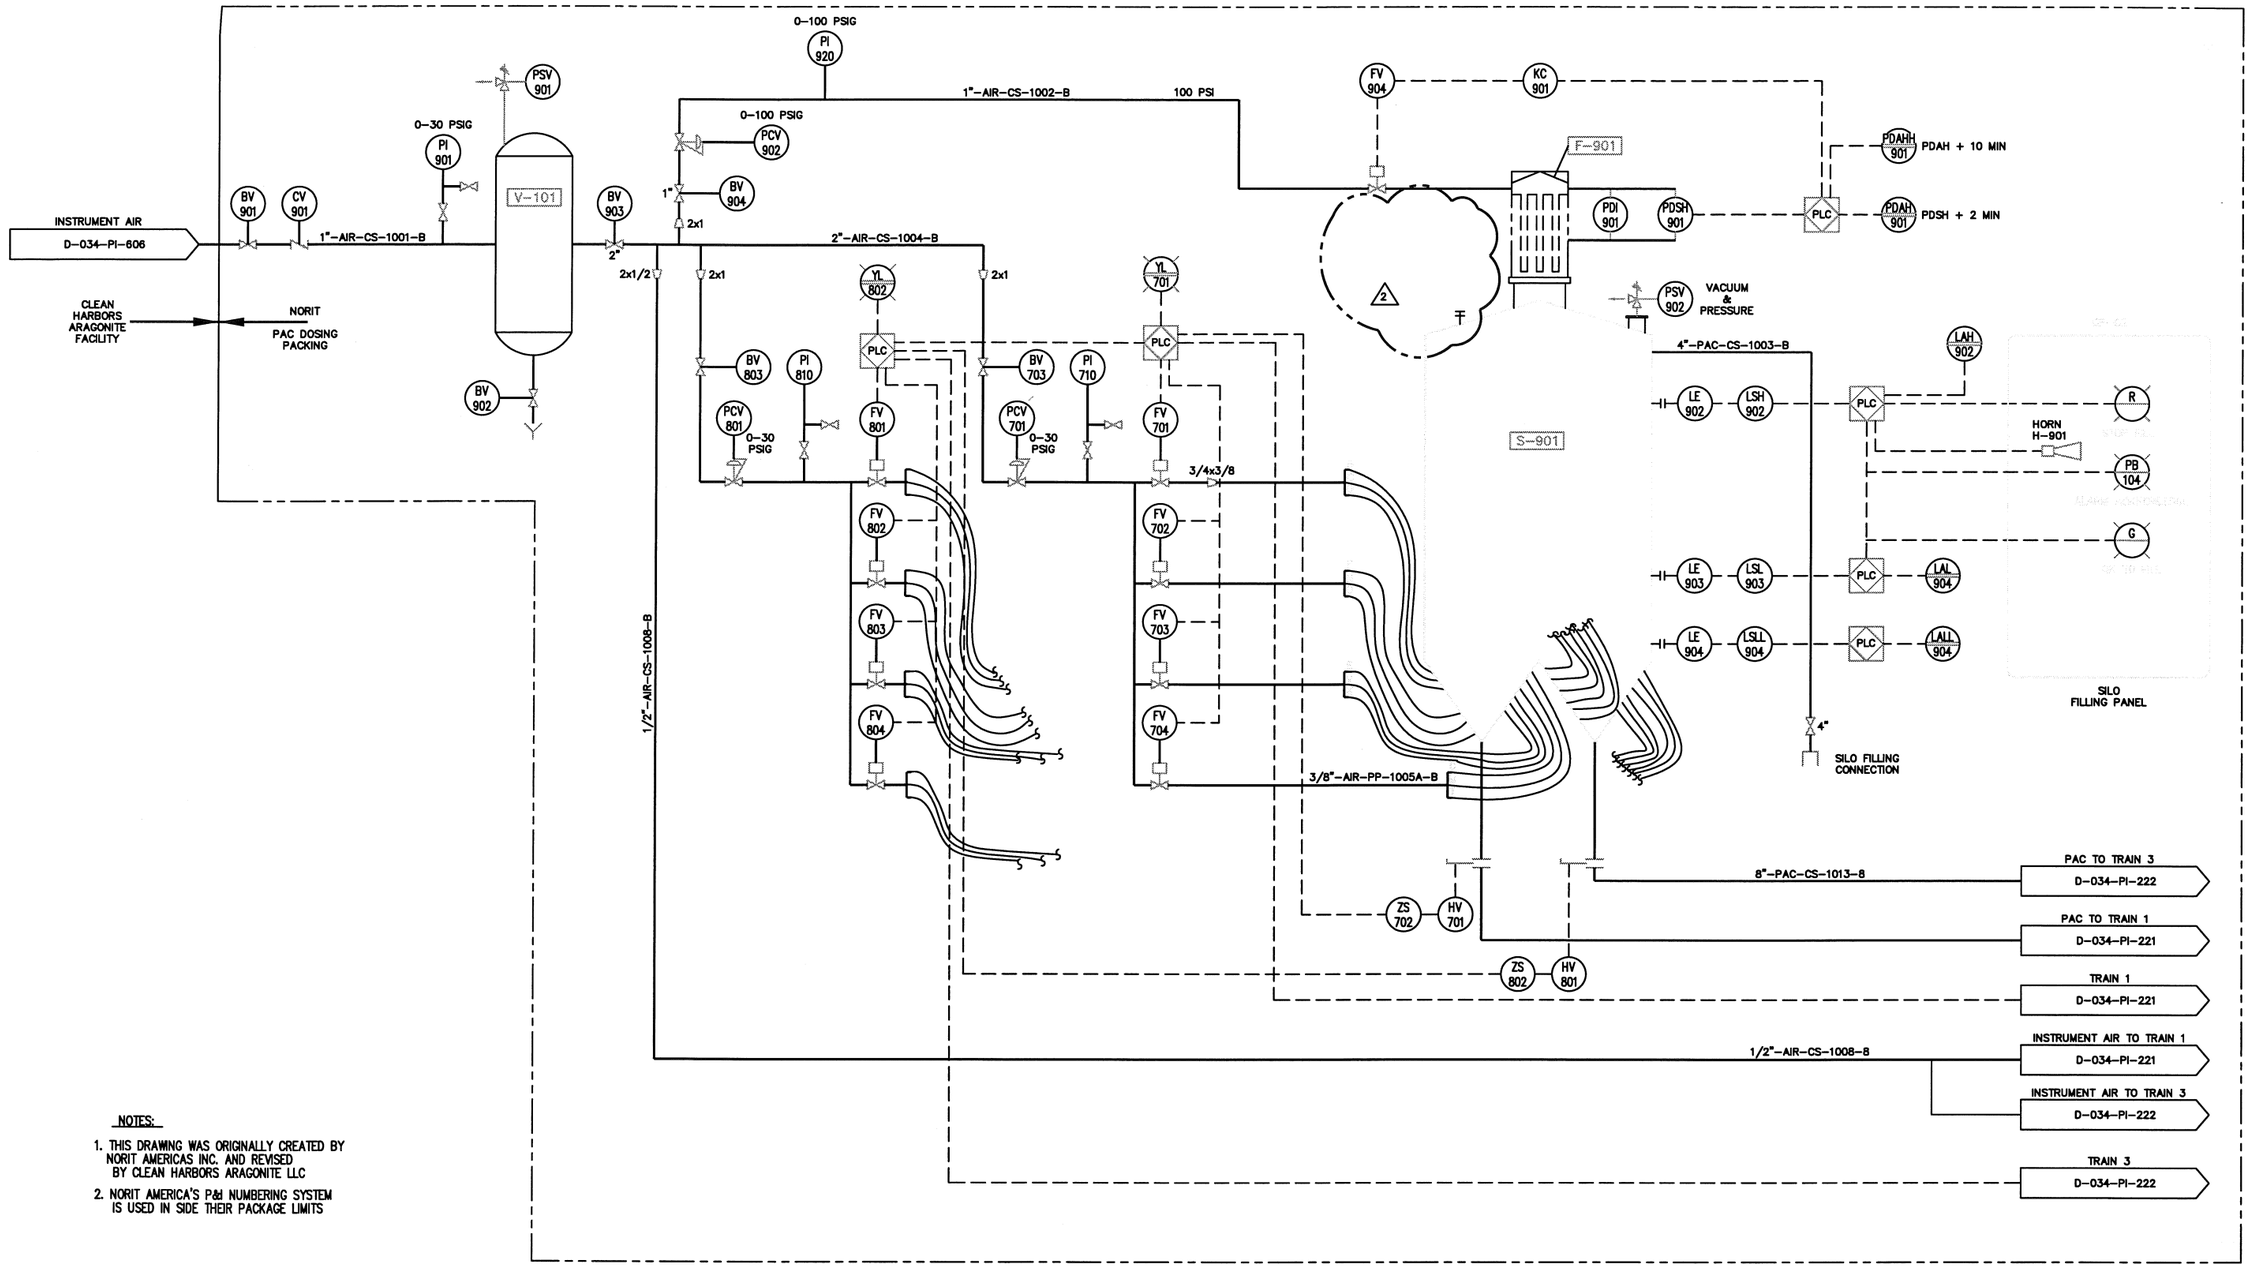

NOTES:

1. THIS DRAWING WAS ORIGINALLY CREATED BY NORIT AMERICAS INC. AND REVISED BY CLEAN HARBORS ARAGONITE LLC
2. NORIT AMERICA'S P&I NUMBERING SYSTEM IS USED IN SIDE THEIR PACKAGE LIMITS

REVISIONS

NO	DESCRIPTION	DATE	BY	CHK		ENG MGR
2	REMOVED LEVEL TRANSMITTER	02-16-05	LCC			
1	REMOVED FLANGE FROM S-901	2-15-01	GVC	BC		
	REMOVED PROPRIETARY STATEMENT					
0	INITIAL DESIGN BY NORIT AMERICA	09-28-00	JKM	BC		

REVISIONS

NO	DESCRIPTION	DATE	BY	CHK		ENG MGR

APPROVALS

	BY	DATE
DRAWN		
CHECKED		
ELEC		
MECH		
STRUCT		
PROJECT ENG		
ENGINEERING MGR		
AS BUILT		

REGISTERED PROFESSIONAL ENGINEER
DATE:_____

CleanHarbors ARAGONITE LLC

THIS DRAWING IS THE PROPERTY OF CLEAN HARBORS ARAGONITE LLC ANY INFORMATION CONTAINED HEREON MAY NOT BE COPIED OR USED WITHOUT WRITTEN PERMISSION OF OWNER.

TITLE UTAH ENVIRONMENTAL SERVICE CENTER
INCINERATION PLANT FOR INDUSTRIAL WASTES
ACTIVATED CARBON SILO
P&ID

FOR

CAD NO. LC100C

SCALE NTS

JOB NO

Clean Harbors DWG No. D-034-PI-220

REV 2