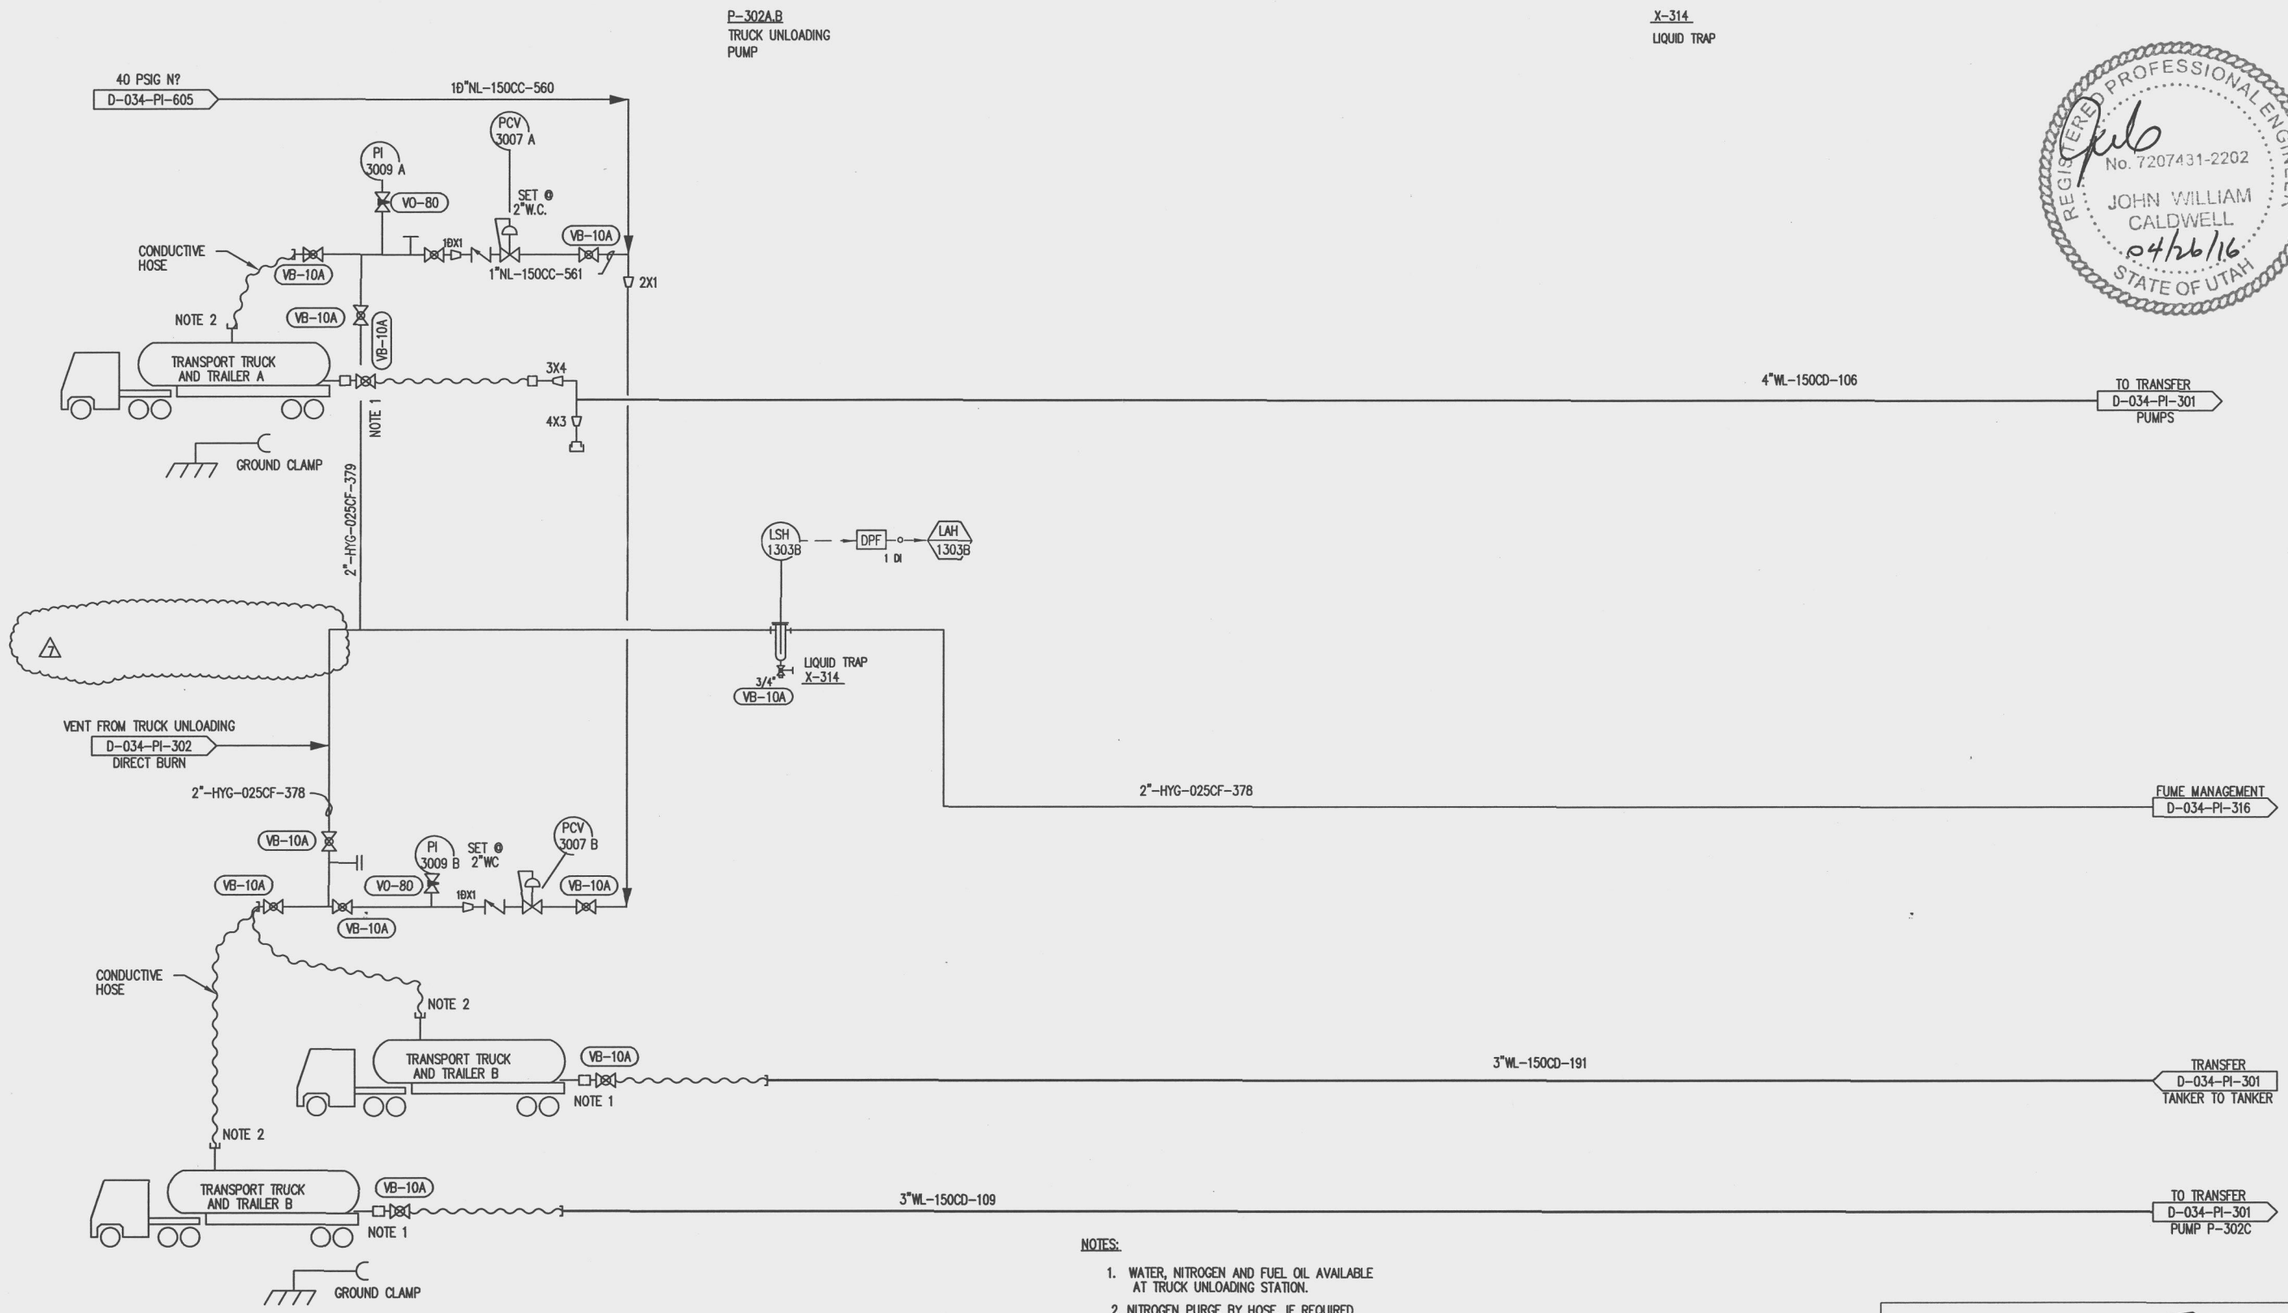

NOTES:

1. WATER, NITROGEN AND FUEL OIL AVAILABLE AT TRUCK UNLOADING STATION.
2. NITROGEN PURGE BY HOSE, IF REQUIRED BY OPERATING PROCEDURES.

REGISTERED PROFESSIONAL ENGINEER
No. 7207431-2202
JOHN WILLIAM CALDWELL
04/26/16
STATE OF UTAH

INTERLOCK

DESCRIPTION

REVISIONS

NO	DESCRIPTION		BY	CHK	LEAD ENG	ELEC	MECH	STR	PROJ ENG	PROJ MGR
8	ISSUED FOR CONSTRUCTION	07/07/89	MU							
7	REMOVED SLUDGE PAD VENT LINE REF									
		04-22-16	MM	LB						
3	AS BUILT	9-20-00	GVC							
4	ADDED TRANSFER TANKER	4-11-01	GVC							
	TO TANKER									
5	ADDED TANKER DIRECT BURN	09-13-02	KL							
	AND REMOVED A-301									

REFERENCE DRAWINGS

DRAWING NO	TITLE

REGISTERED PROFESSIONAL ENGINEER
DATE:_____

APPROVALS

	BY	DATE
DRAWN	CRM	2-30-96
CHECKED		
LEAD ENG.		
ELEC CHECK		
MECH CHECK		
STRUCT CHECK		
PROJECT ENG		
PROJECT MGR		

CURRENT DRAWING STATUS

	BY	DATE
PRELIMINARY OR PLANNING	KRP	2-17-88
APPROVED FOR FINAL DESIGN		
APPROVED FOR QUOTE/PURCH		
APPROVED FOR CONSTRUCTION		
AS-BUILT		

CleanHarbors®
ARAGONITE LLC

THIS DRAWING IS THE PROPERTY OF CLEAN HARBORS ARAGONITE LLC
ANY INFORMATION CONTAINED HEREON MAY NOT BE COPIED
OR USED WITHOUT WRITTEN PERMISSION OF OWNER.

TITLE

UTAH ENVIRONMENTAL SERVICE CENTER
TRUCK UNLOADING AREA
P&ID LIQUID UNLOADING PUMPS

FOR CLEAN HARBORS

CAD DISK FILE 11635

SCALE	JOB NO	ENG. DWG NO	APTUS DWG NO	REV
NONE	W6068R		D-034-PI-300	7