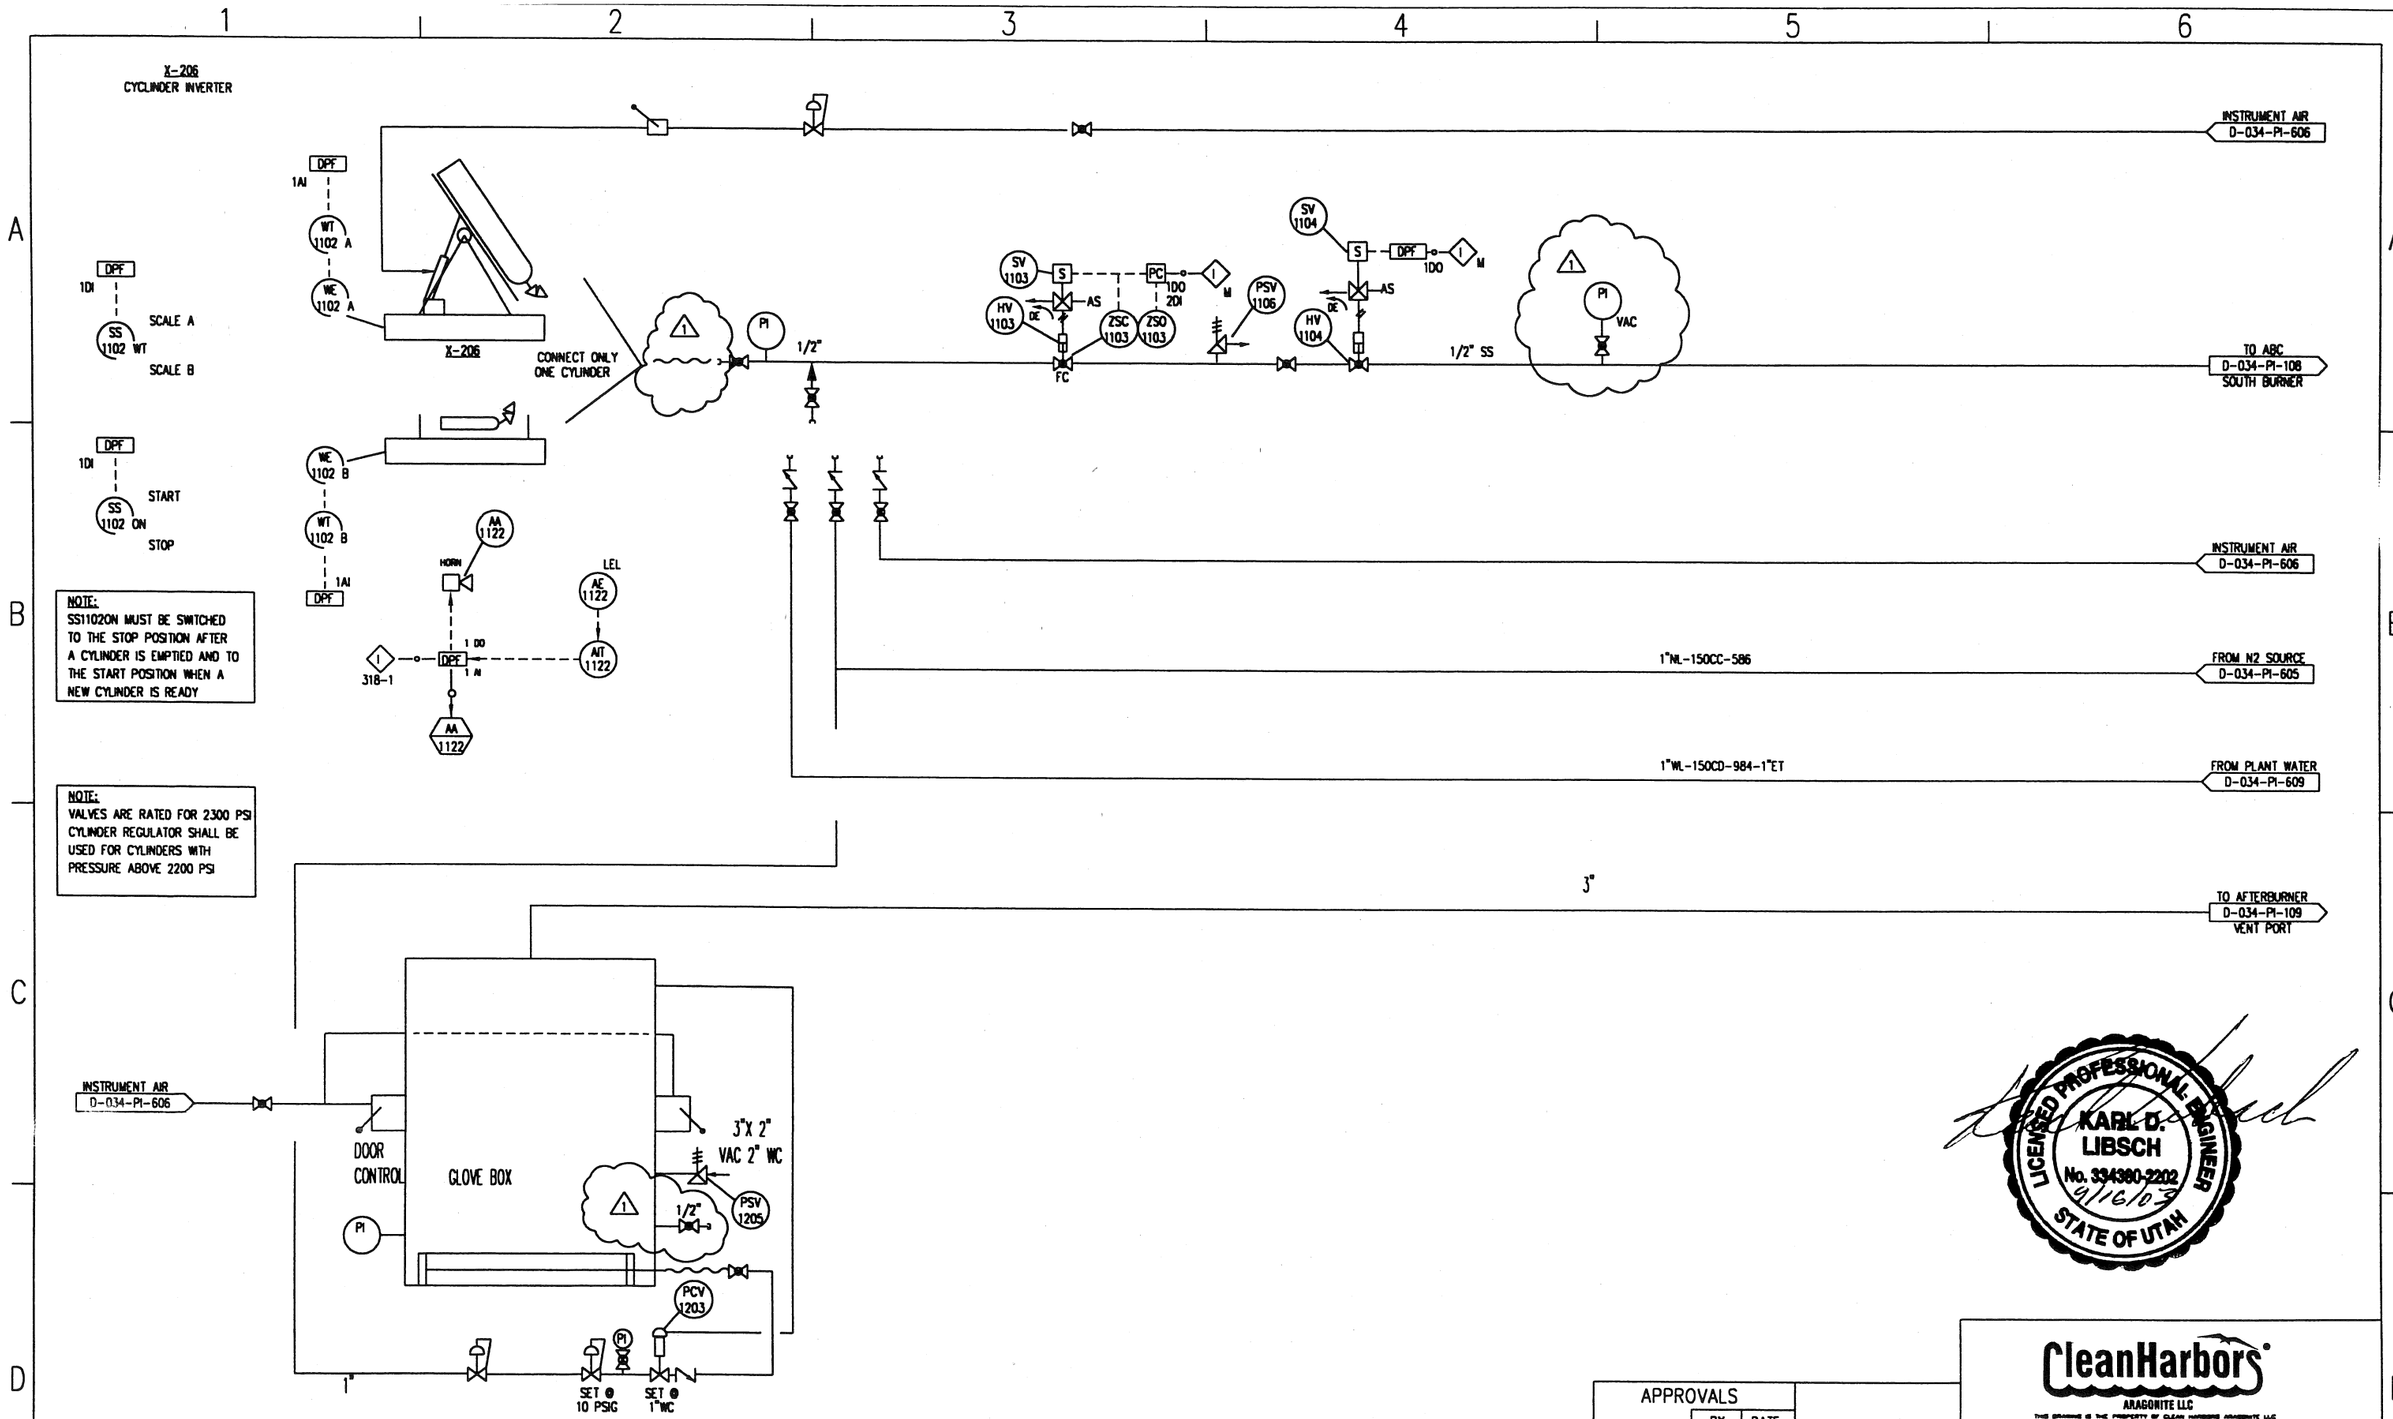

NOTE:
SS1102ON MUST BE SWITCHED TO THE STOP POSITION AFTER A CYLINDER IS EMPTIED AND TO THE START POSITION WHEN A NEW CYLINDER IS READY

NOTE:
VALVES ARE RATED FOR 2300 PSI
CYLINDER REGULATOR SHALL BE USED FOR CYLINDERS WITH PRESSURE ABOVE 2200 PSI

LICENSED PROFESSIONAL ENGINEER
KARL D. LIBSCH
No. 334380-2202
9/16/03
STATE OF UTAH

INTERLOCK DESCRIPTION

M - MASTER INTERLOCK SYSTEM
318-1 HIGH LEL SHUTS DOWN CYLINDER FEED

REVISIONS

NO	DESCRIPTION	DATE	BY	CHK		ENG MGR
0	AS BUILT	06-19-03	LC			
1	ADDED VALVE TO GLOVE BOX, REMOVED PI	09-12-03	LC			
	ADDED VACUUM GAUGE					

REVISIONS

NO	DESCRIPTION	DATE	BY	CHK		ENG MGR

APPROVALS

	BY	DATE
DRAWN	LCC	12-31-02
CHECKED		
ELEC		
MECH		
STRUCT		
PROJECT ENG		
ENGINEERING MGR		
AS BUILT		

REGISTERED PROFESSIONAL ENGINEER
DATE:

CleanHarbors®
ARAGONITE LLC

THIS DRAWING IS THE PROPERTY OF CLEAN HARBORS ARAGONITE, LLC ANY INFORMATION CONTAINED HEREON MAY NOT BE COPIED OR USED WITHOUT WRITTEN PERMISSION OF OWNER.

TITLE
UTAH ENVIRONMENTAL SERVICE CENTER
INCINERATION PLANT FOR INDUSTRIAL WASTES
P&ID COMPRESSED GAS WASTE

FOR	TOOELE SITE	CAD NO.	H791F	
SCALE	JOB NO	SAFETY-KLEEN DWG NO	D-034-PI-318	REV 1