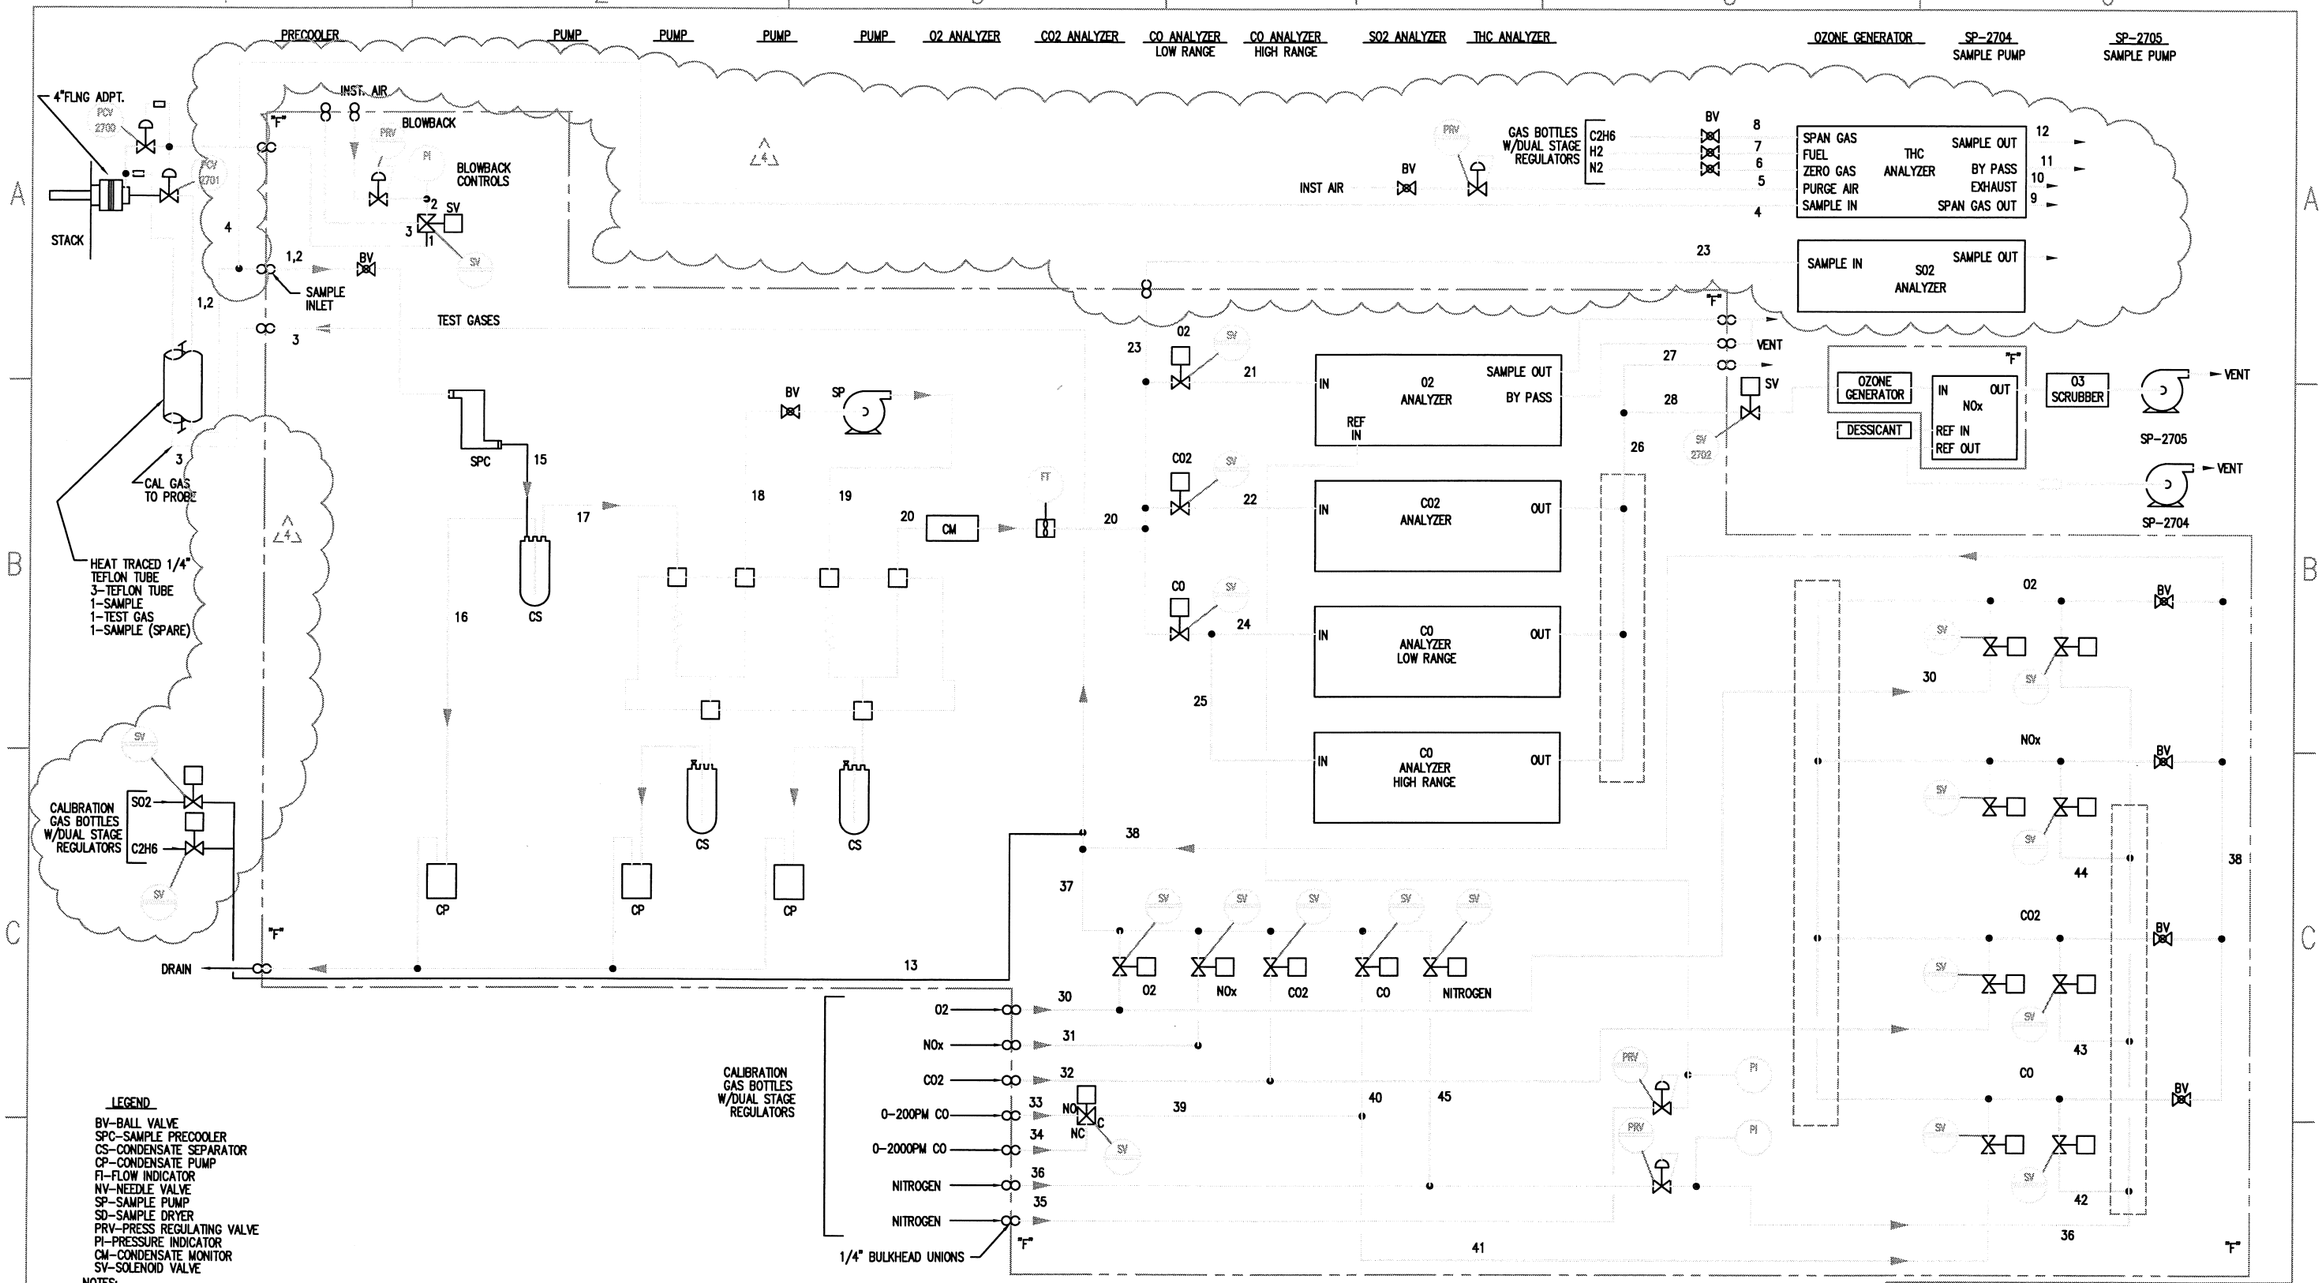

LEGEND

BV-BALL VALVE
SPC-SAMPLE PRECOOLER
CS-CONDENSATE SEPARATOR
CP-CONDENSATE PUMP
FI-FLOW INDICATOR
NV-NEEDLE VALVE
SP-SAMPLE PUMP
SD-SAMPLE DRYER
PRV-PRESS REGULATING VALVE
PI-PRESSURE INDICATOR
CM-CONDENSATE MONITOR
SV-SOLENOID VALVE

NOTES:

1. THIS DRAWING WAS ORIGINALLY CREATED BY ROSEMOUNT ANALYTICAL INC. AND REVISED BY APTUS INC.

REFERENCE DRAWINGS

DRAWING NO	TITLE

REVISIONS

NO	DESCRIPTION	DATE	BY	CHK		ENG MGR
1	CHANGE DWG. FROM AP464A TO D-800-PI-215	04-18-00	GVC			
2	AS BUILT	04-27-00	KGB			
3	CHANGE DWG. FROM AP464B TO AP464C	09-16-02	KL			
4	ADDED SO2 AND THC ANALYZERS	10-23-03	LCC			

REVISIONS

NO	DESCRIPTION	DATE	BY	CHK		ENG MGR

APPROVALS

	BY	DATE
DRAWN	DCP	01-25-95
CHECKED		
ELEC		
MECH		
STRUCT		
PROJECT ENG		
ENGINEERING MGR		
AS BUILT		

REGISTERED PROFESSIONAL ENGINEER
DATE:

CleanHarbors
ARAGONITE LLC

TITLE
UTAH ENVIRONMENTAL SERVICE CENTER
PIPING DIAGRAM
CEM #1 SYSTEM

FOR	TOOELE SITE	CAD NO.	AP464D
SCALE NA	ROSEMOUNT DWG. NO. 3D38359	APTUS DWG NO D-800-PI-215	REV 4