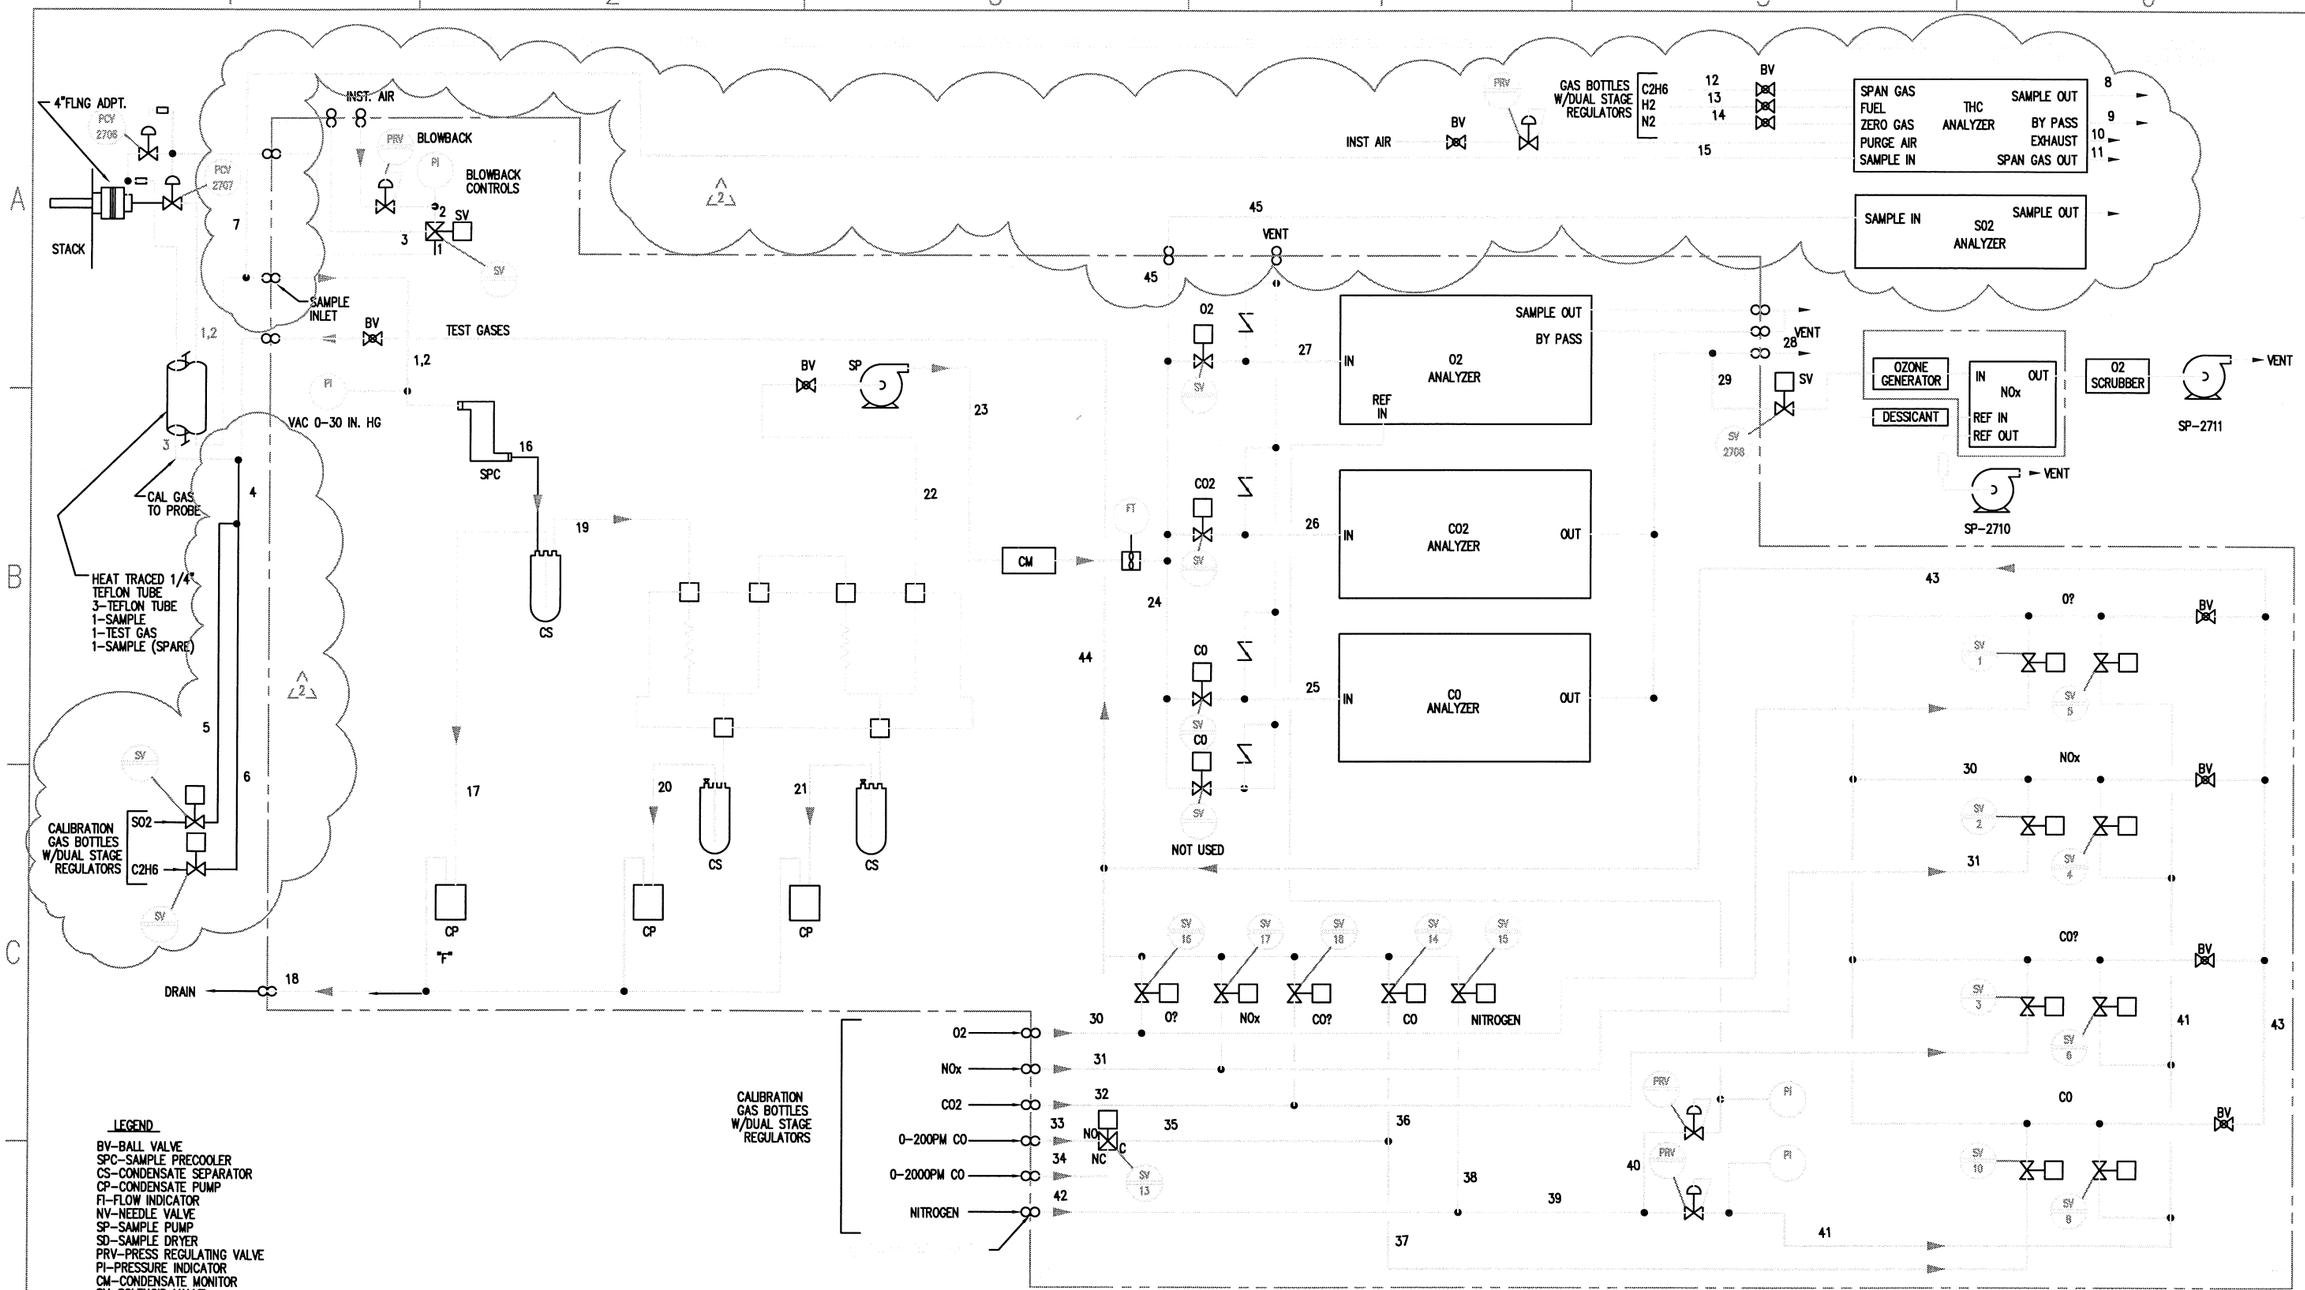

LEGEND

BV-BALL VALVE
SPC-SAMPLE PRECOOLER
CS-CONDENSATE SEPARATOR
CP-CONDENSATE PUMP
FI-FLOW INDICATOR
NV-NEEDLE VALVE
SP-SAMPLE PUMP
SD-SAMPLE DRYER
PRV-PRESS REGULATING VALVE
PI-PRESSURE INDICATOR
CM-CONDENSATE MONITOR
SV-SOLENOID VALVE

NOTES:

1. THIS DRAWING WAS ORIGINALLY CREATED BY ROSEMOUNT ANALYTICAL INC. AND REVISED BY APTUS INC.

REFERENCE DRAWINGS

DRAWING NO	TITLE

REVISIONS

NO	DESCRIPTION		
0	AS BUILT	4-27-00	KGB
1	CHANGE CAD NO. FROM AP464B TO AP462A	09-16-02	KL
2	ADDED S02 AND THC ANALYZERS	10-23-03	LCC

REVISIONS

NO	DESCRIPTION

APPROVALS

	BY	DATE

CleanHarbors ARAGONITE LLC

UTAH ENVIRONMENTAL SERVICE CENTER
PIPING DIAGRAM
CEM #2 SYSTEM

TOOELE SITE | AP462B

3038359 | D-800-PI-216 | 2