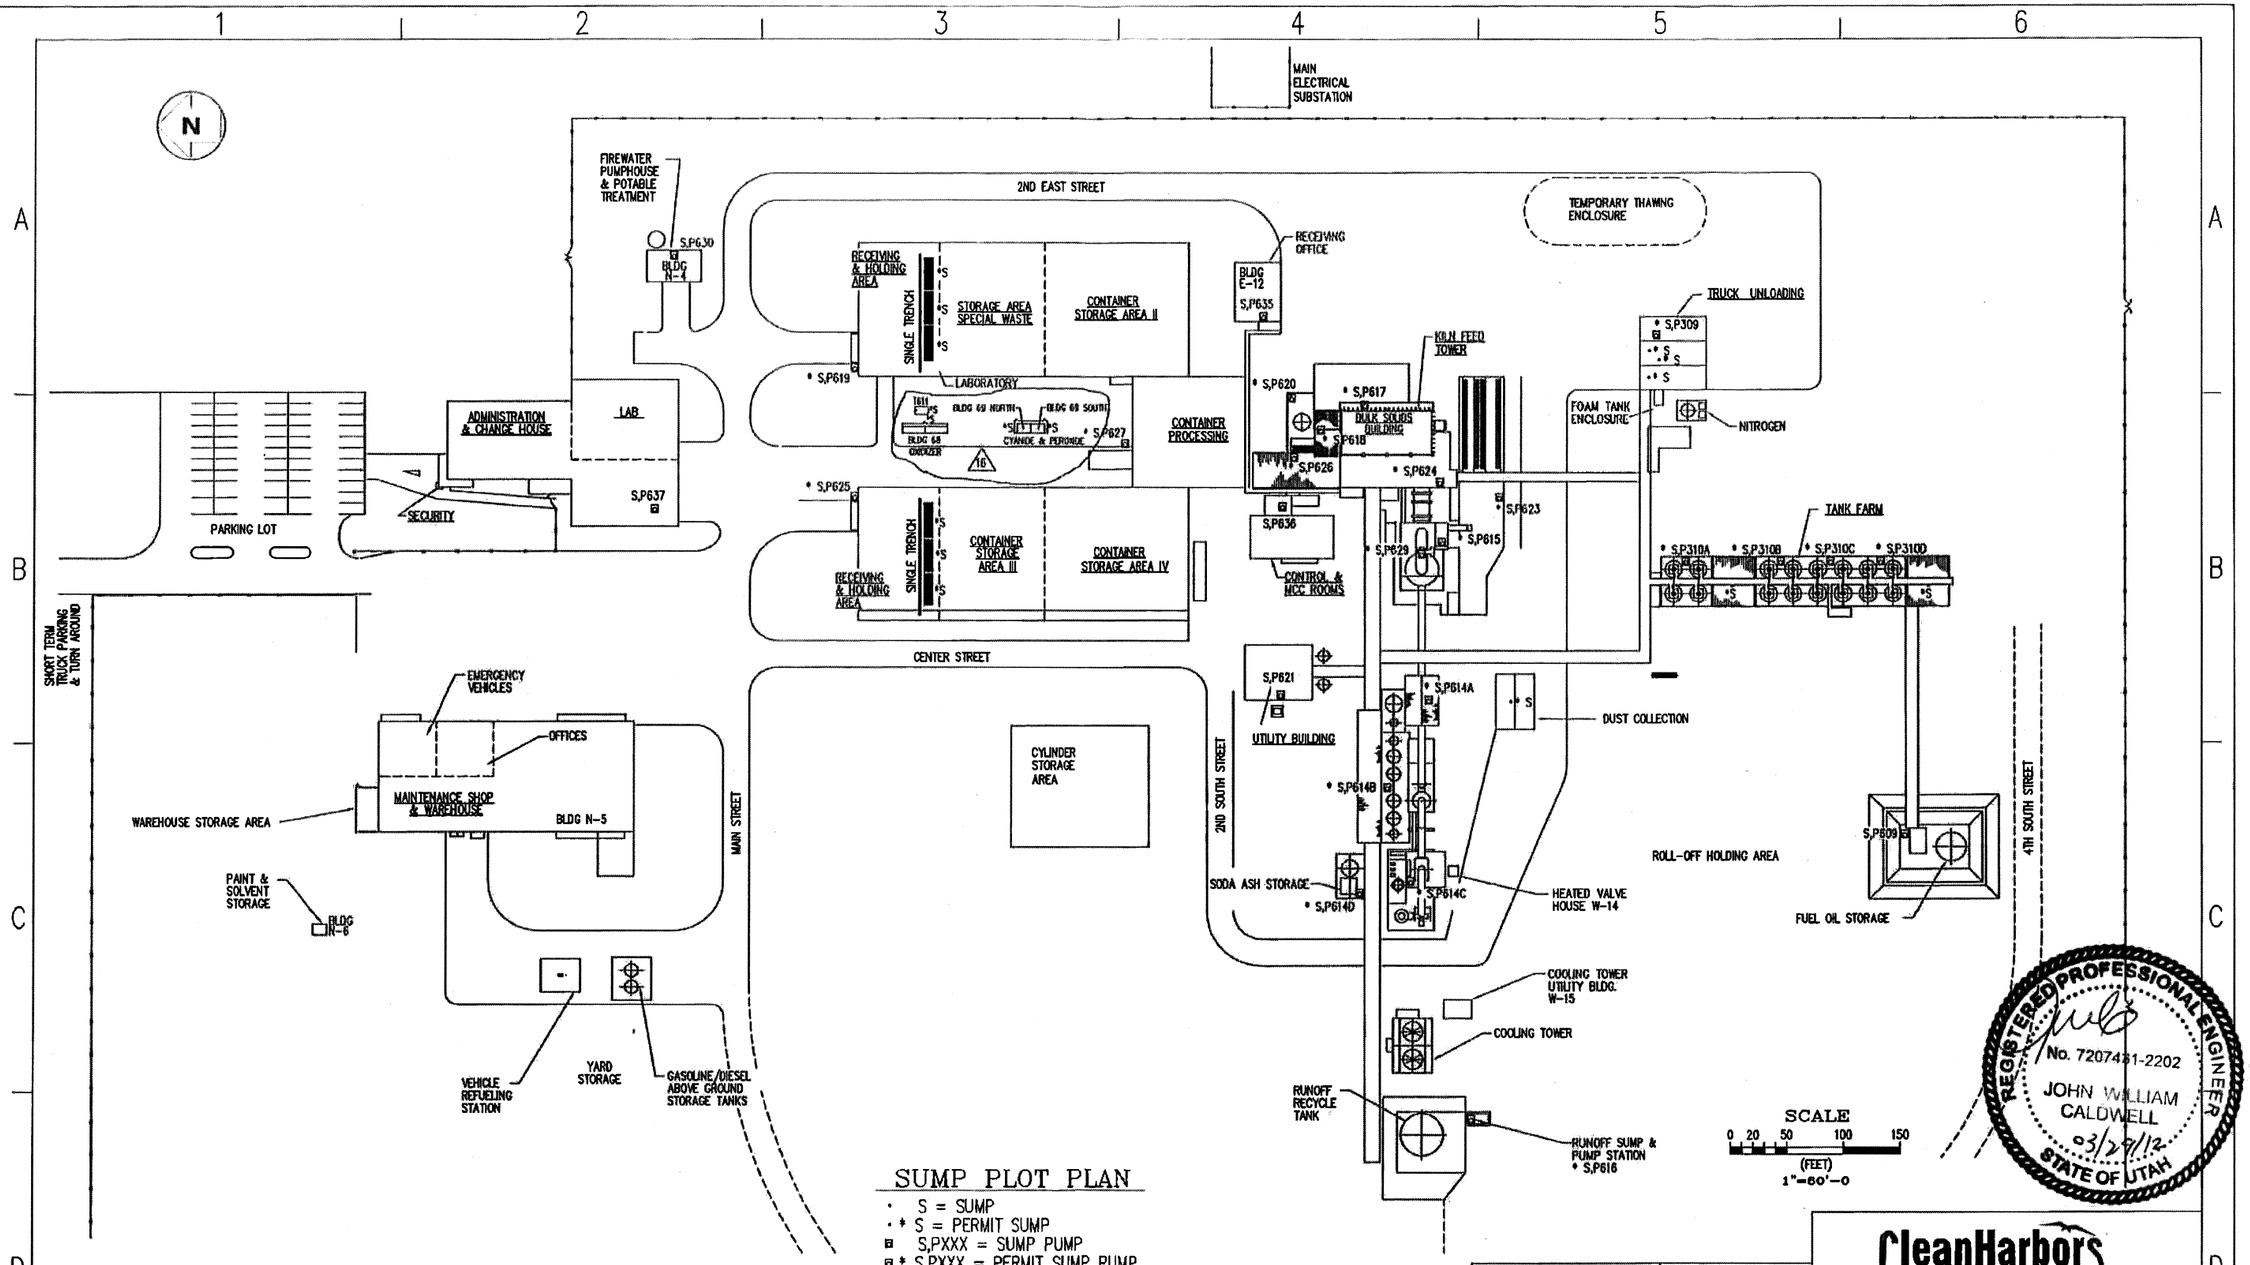

SUMP PLOT PLAN

- S = SUMP
- * S = PERMIT SUMP
- S,PXXX = SUMP PUMP
- * S,PXXX = PERMIT SUMP PUMP

REFERENCE DRAWINGS	
DRAWING NO	TITLE

REVISIONS						
NO	DESCRIPTION	DATE	BY	CHK		ENG MGR
15	RELOCATE T611, AS BUILT BLDGS 68 & 69	10-5-2011	TJK			TJK
16	ADD REF NORTH & SOUTH COMPARTMENTS BLDG 69	03-28-12	TJK			TJK
7	ADDED S,P614D	09-23-91	DCP			CHW
8	UPDATED DWG. FOR TEMP. BLDGS.	11-11-92	DCP			CHW
9	ADDED WAREHOUSE STORAGE FENCE	03-22-93	DCP			CHW

REVISIONS						
NO	DESCRIPTION	DATE	BY	CHK		ENG MGR
10	PERMIT SUMPS & SUMP PUMPS' LOCATION	07-10-95	DCP			
11	REMOVAL OF SUMP TRENCHES	2-17-00	GVC			
12	ADDED CYLINDER STORAGE, OTHER CHANGES	6-9-03	KL			
13	ADDED SUMP	02-22-08	KL			
14	ADDED T611, BLDG 68 & 69 WITH SUMPS	4OCT10	BAD	WC		BAD

APPROVALS	BY	DATE
DRAWN	cmm	12-18-96
CHECKED		
ELEC		
MECH		
STRUCT		
PROJECT ENG		
ENGINEERING MGR		
AS BUILT		

REGISTERED PROFESSIONAL ENGINEER
DATE:

CleanHarbors
ARAGONITE LLC

THIS DRAWING IS THE PROPERTY OF CLEAN HARBORS ARAGONITE LLC ANY INFORMATION CONTAINED HEREON MAY NOT BE COPIED OR USED WITHOUT WRITTEN PERMISSION OF OWNER.

TITLE
UTAH ENVIRONMENTAL SERVICE CENTER
INCINERATION PLANT FOR INDUSTRIAL WASTES
SUMP AND SUMP PUMP LOCATION

FOR	TOOELE SITE	CAD NO.	MA065H
SCALE 1"= 60'-0"	JOB NO	APTUS DWG NO D-034-M-002-SP	REV 16