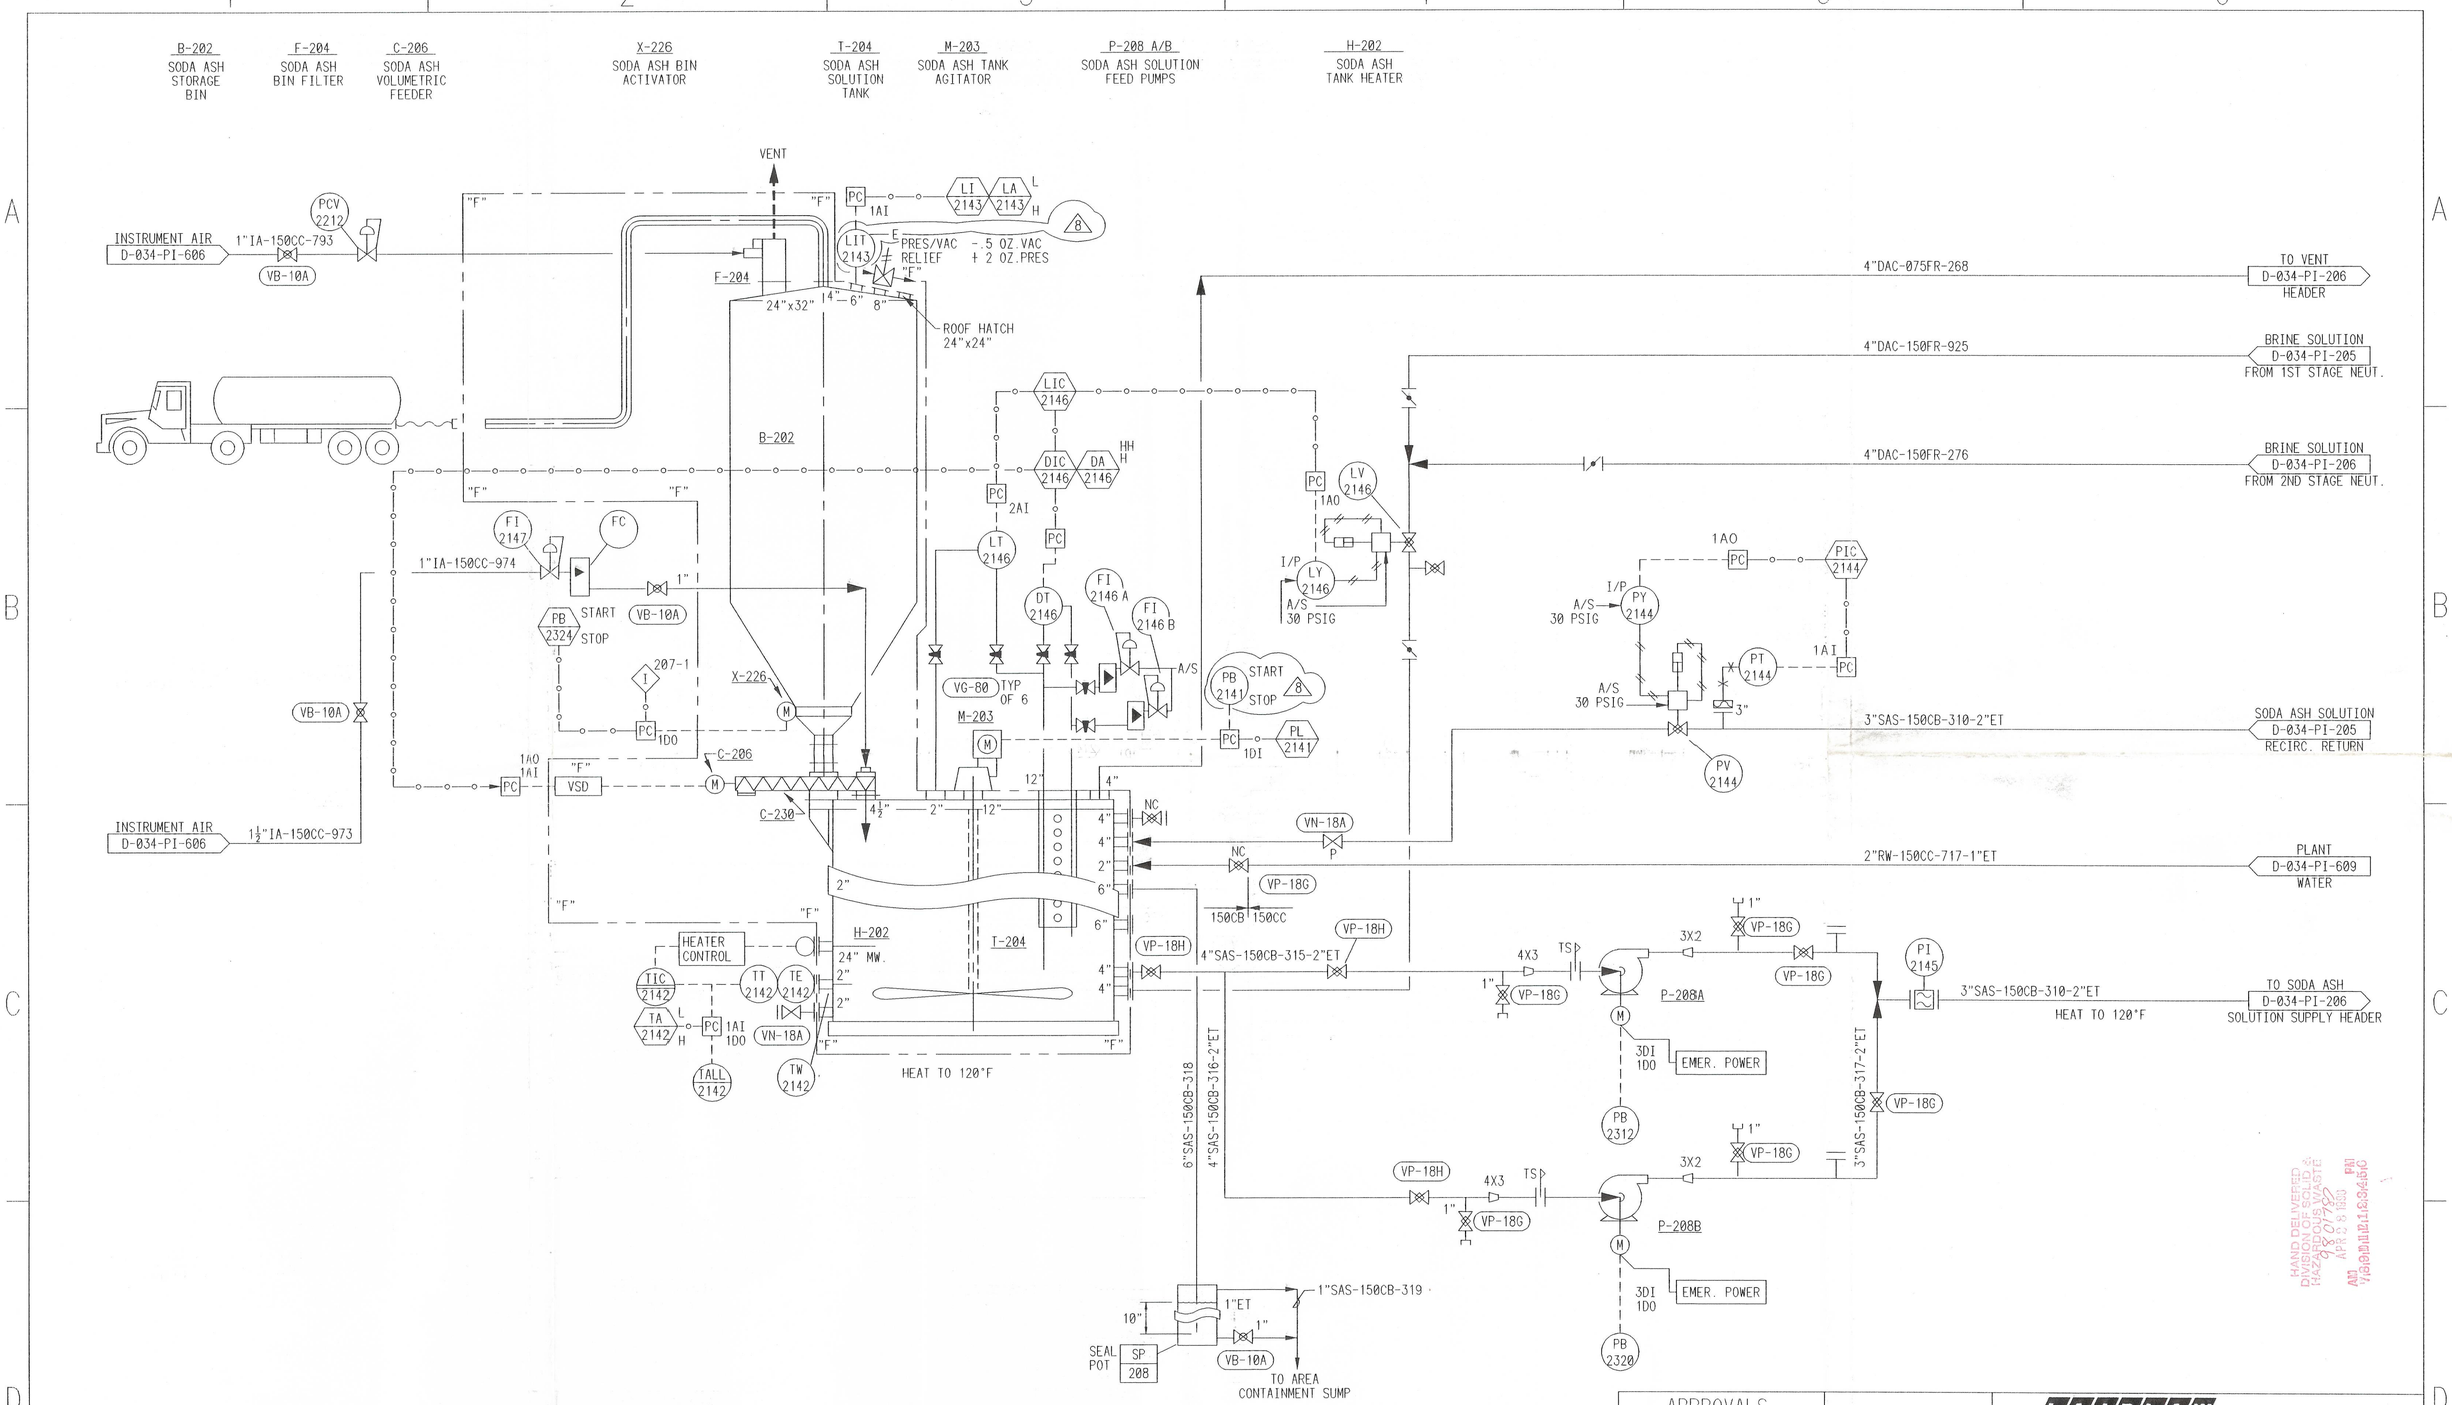

INTERLOCK DESCRIPTION

207-1 FEED SEQUENCE CONTROL

REVISIONS

NO	DESCRIPTION	DATE	BY	CHK		ENG MGR
0	ISSUED FOR CONSTRUCTION	7-7-89	MU	IRB		JV
1	MODIFIED PIPING	07/09/90	DCP	CHW		JV
2	AS BUILT	06-27-91	DCP	TB		CHW
3	AS BUILT	10-17-91	DCP			CHW
4	AS BUILT	12-06-93	DCP	JV		CHW

REVISIONS

NO	DESCRIPTION	DATE	BY	CHK		ENG MGR
5	AS BUILT UPDATE FOR SODA ASH CONTROLS	08-31-94	DCP	JV		CHW
6	RELOCATED PT-2144, PV-2144 & LV-2146	03-12-96	DCP			
7	AS BUILT	03-13-97	CRM			
8	TO CORRECT DRAFTING ERRORS	04-07-98	CRM			

APPROVALS

	BY	DATE
DRAWN	CRM	03-13-97
CHECKED		
ELEC		
MECH		
STRUCT		
PROJECT ENG		
ENGINEERING MGR		
AS BUILT		

LICENSED PROFESSIONAL ENGINEER No. 179080 MARTIN JOHN BARTH STATE OF UTAH

REGISTERED PROFESSIONAL ENGINEER DATE: 4/27/98

LAIDLAW ENVIRONMENTAL SERVICES (ARAGONITE), INC.
11600 NORTH APTUS ROAD, ARAGONITE, UT. 84029

TITLE: UTAH ENVIRONMENTAL SERVICE CENTER INCINERATION PLANT FOR INDUSTRIAL WASTE P&ID SODA ASH STORAGE HANDLING SYSTEM

FOR: TOOELE SITE | CAD NO. IH784K
SCALE | JOB NO | APTUS DWG NO D-034-PI-207 | REV 8

HAND DELIVERED DIVISION OF SOLID & HAZARDOUS WASTE 98 07 02 APR 2 8 1998 AM 7:00 PM 1:23:45