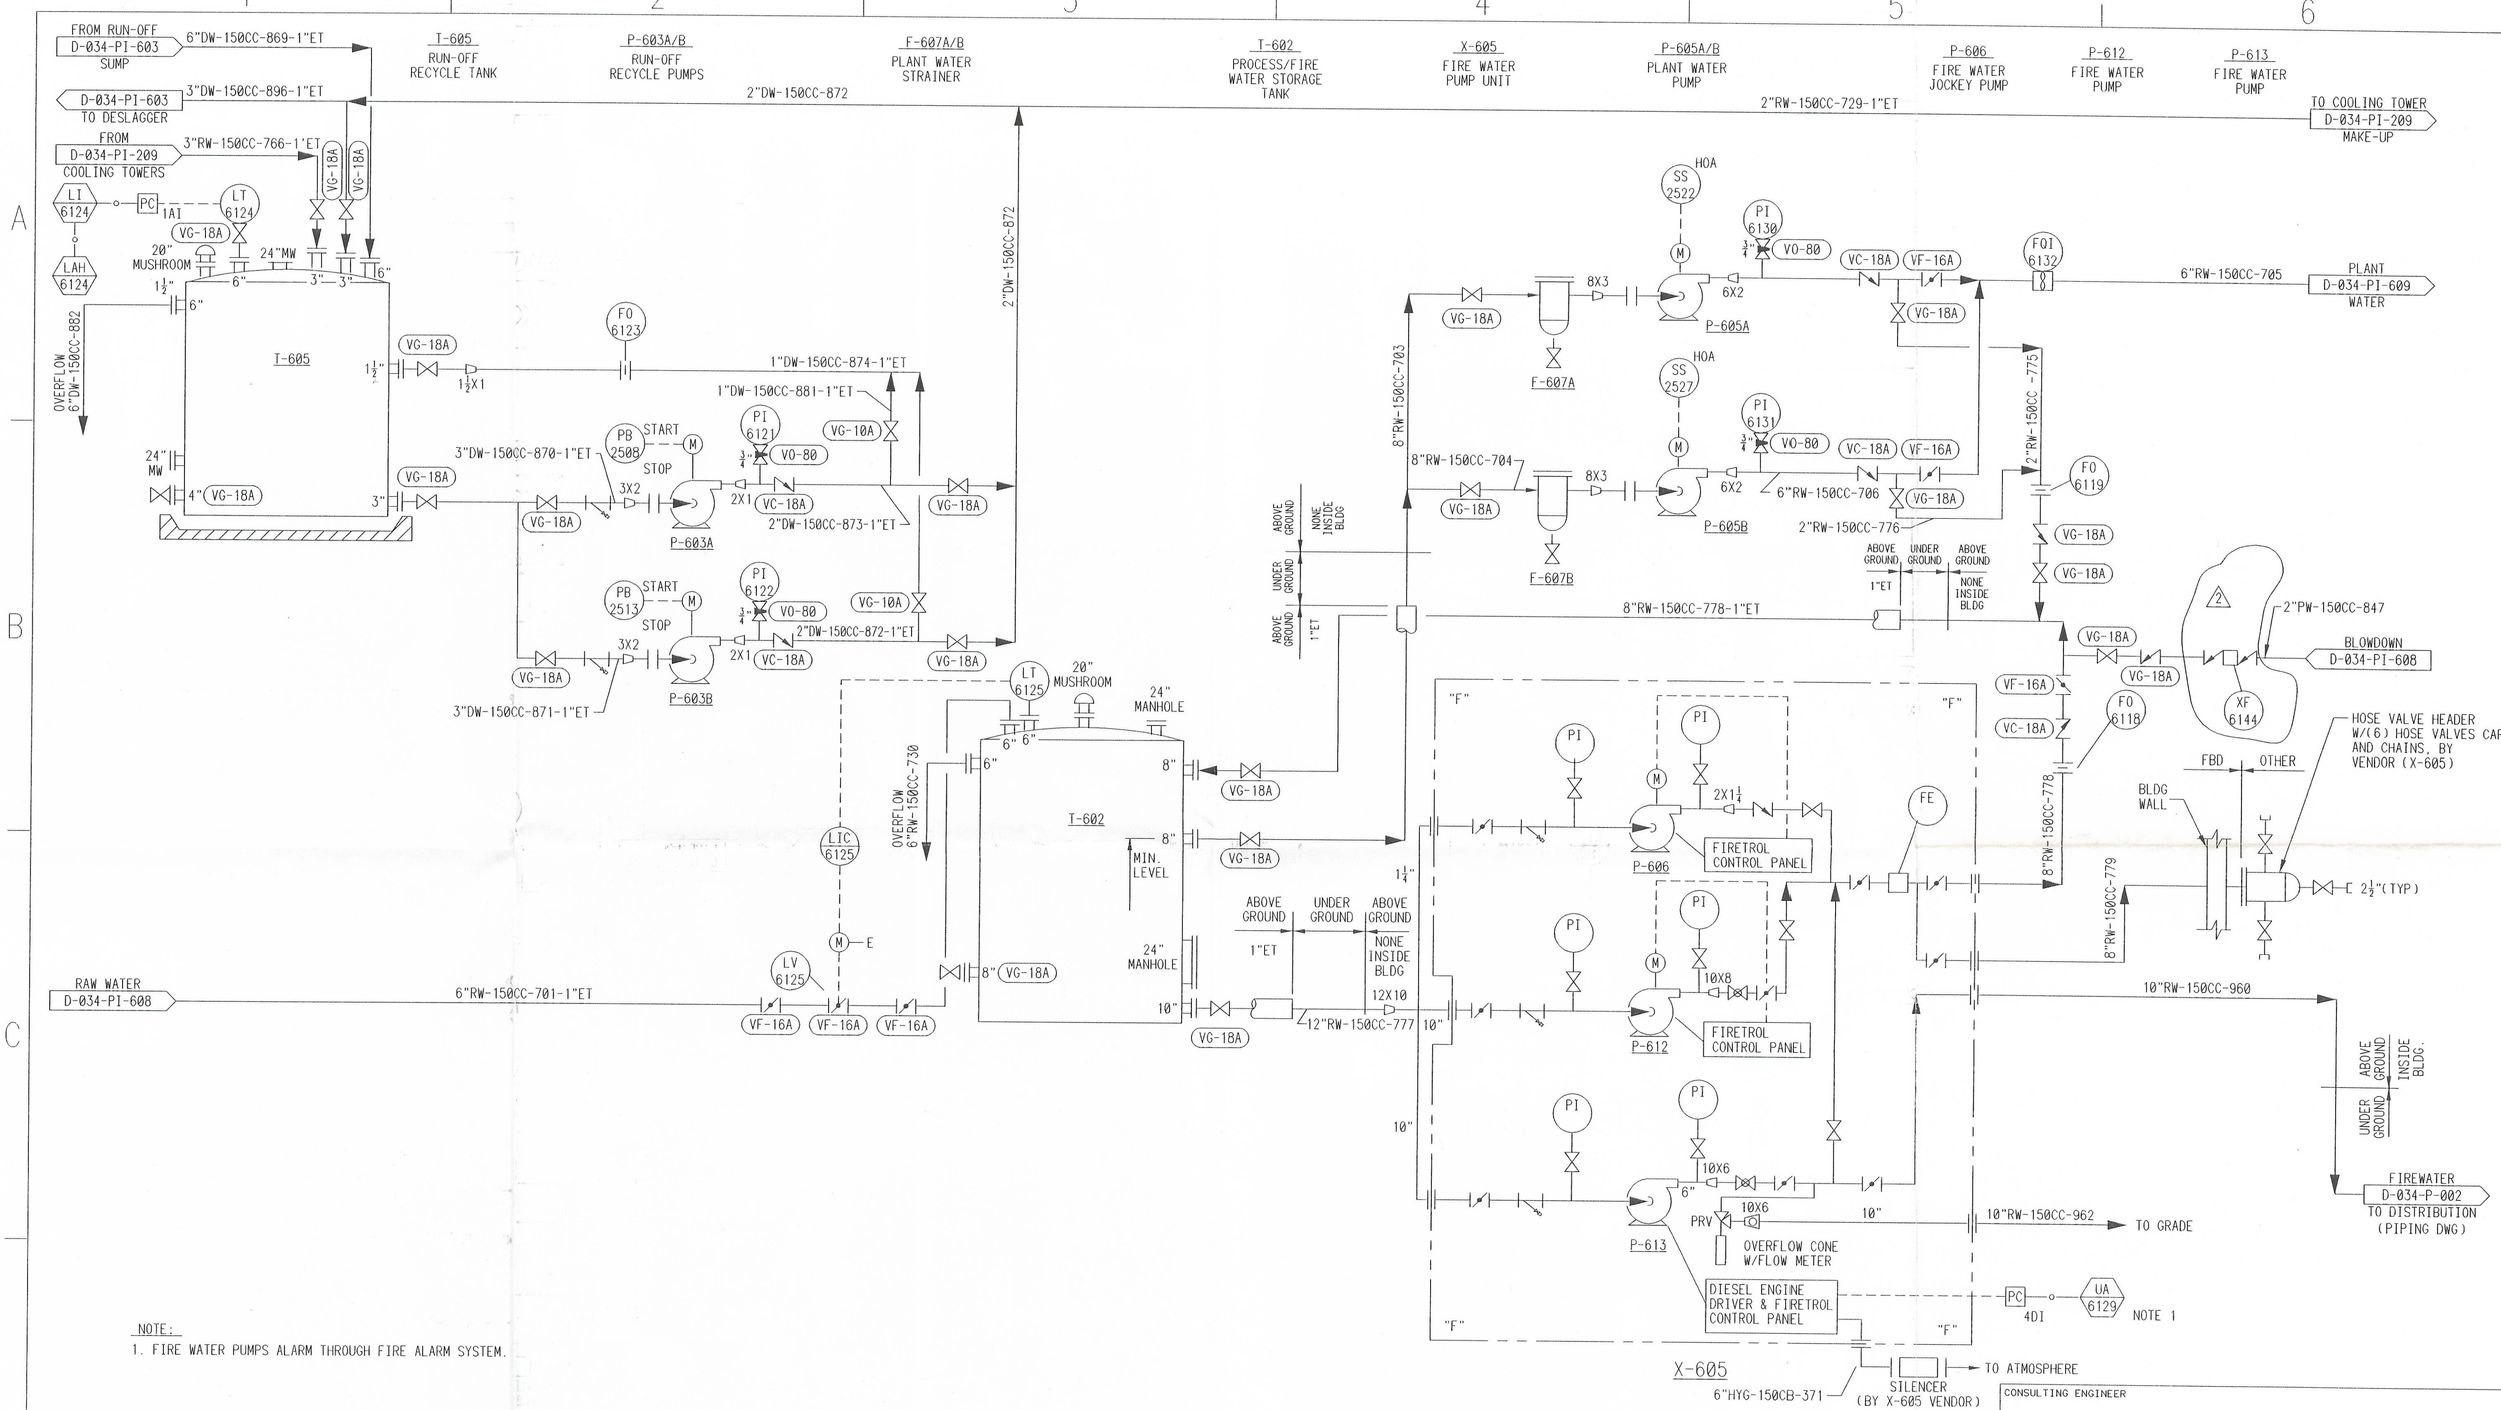

NOTE:
1. FIRE WATER PUMPS ALARM THROUGH FIRE ALARM SYSTEM.

INTERLOCK

DESCRIPTION

REVISIONS

NO	DESCRIPTION	DATE	BY	CHK	ELEC	MECH	STR	PROJ MGR
0	ISSUED FOR CONSTRUCTION	17-7-89	MU	IRB				JV
1	AS BUILT	11-17-93	DCP					
2	ADDED BACK FLOW PREVENTER	2-15-00	GVC					GVC

REFERENCE DRAWINGS

DRAWING NO	TITLE

REGISTERED PROFESSIONAL ENGINEER
No. 162330
THOMAS T. FUJIKAWA
STATE OF UTAH

REGISTERED PROFESSIONAL ENGINEER
DATE: 3-1-01

APPROVALS

	BY	DATE
DRAWN	DCP	11-17-93
CHECKED		
LEAD ENG.		
ELEC CHECK		
MECH CHECK		
STRUCT CHECK		
PROJECT ENG		
PROJECT MGR		

CURRENT DRAWING STATUS

	BY	DATE
PRELIMINARY OR PLANNING		
APPROVED FOR FINAL DESIGN		
APPROVED FOR QUOTE/PURCH		
APPROVED FOR CONSTRUCTION		
AS-BUILT		

CONSULTING ENGINEER

APTUS
11600 NORTH APTUS ROAD, ARAGONITE, UT. 84029 (801) 531-4200

TITLE
UTAH ENVIRONMENTAL SERVICE CENTER
INCINERATION PLANT FOR INDUSTRIAL WASTES
P&ID PLANT WATER, GRAY WATER, FIRE WATER

FOR TOOELE SITE

CAD DISK FILE IH787G

SCALE	JOB NO	ENG. DWG NO	APTUS DWG NO	REV
NONE			D-034-PI-607	2