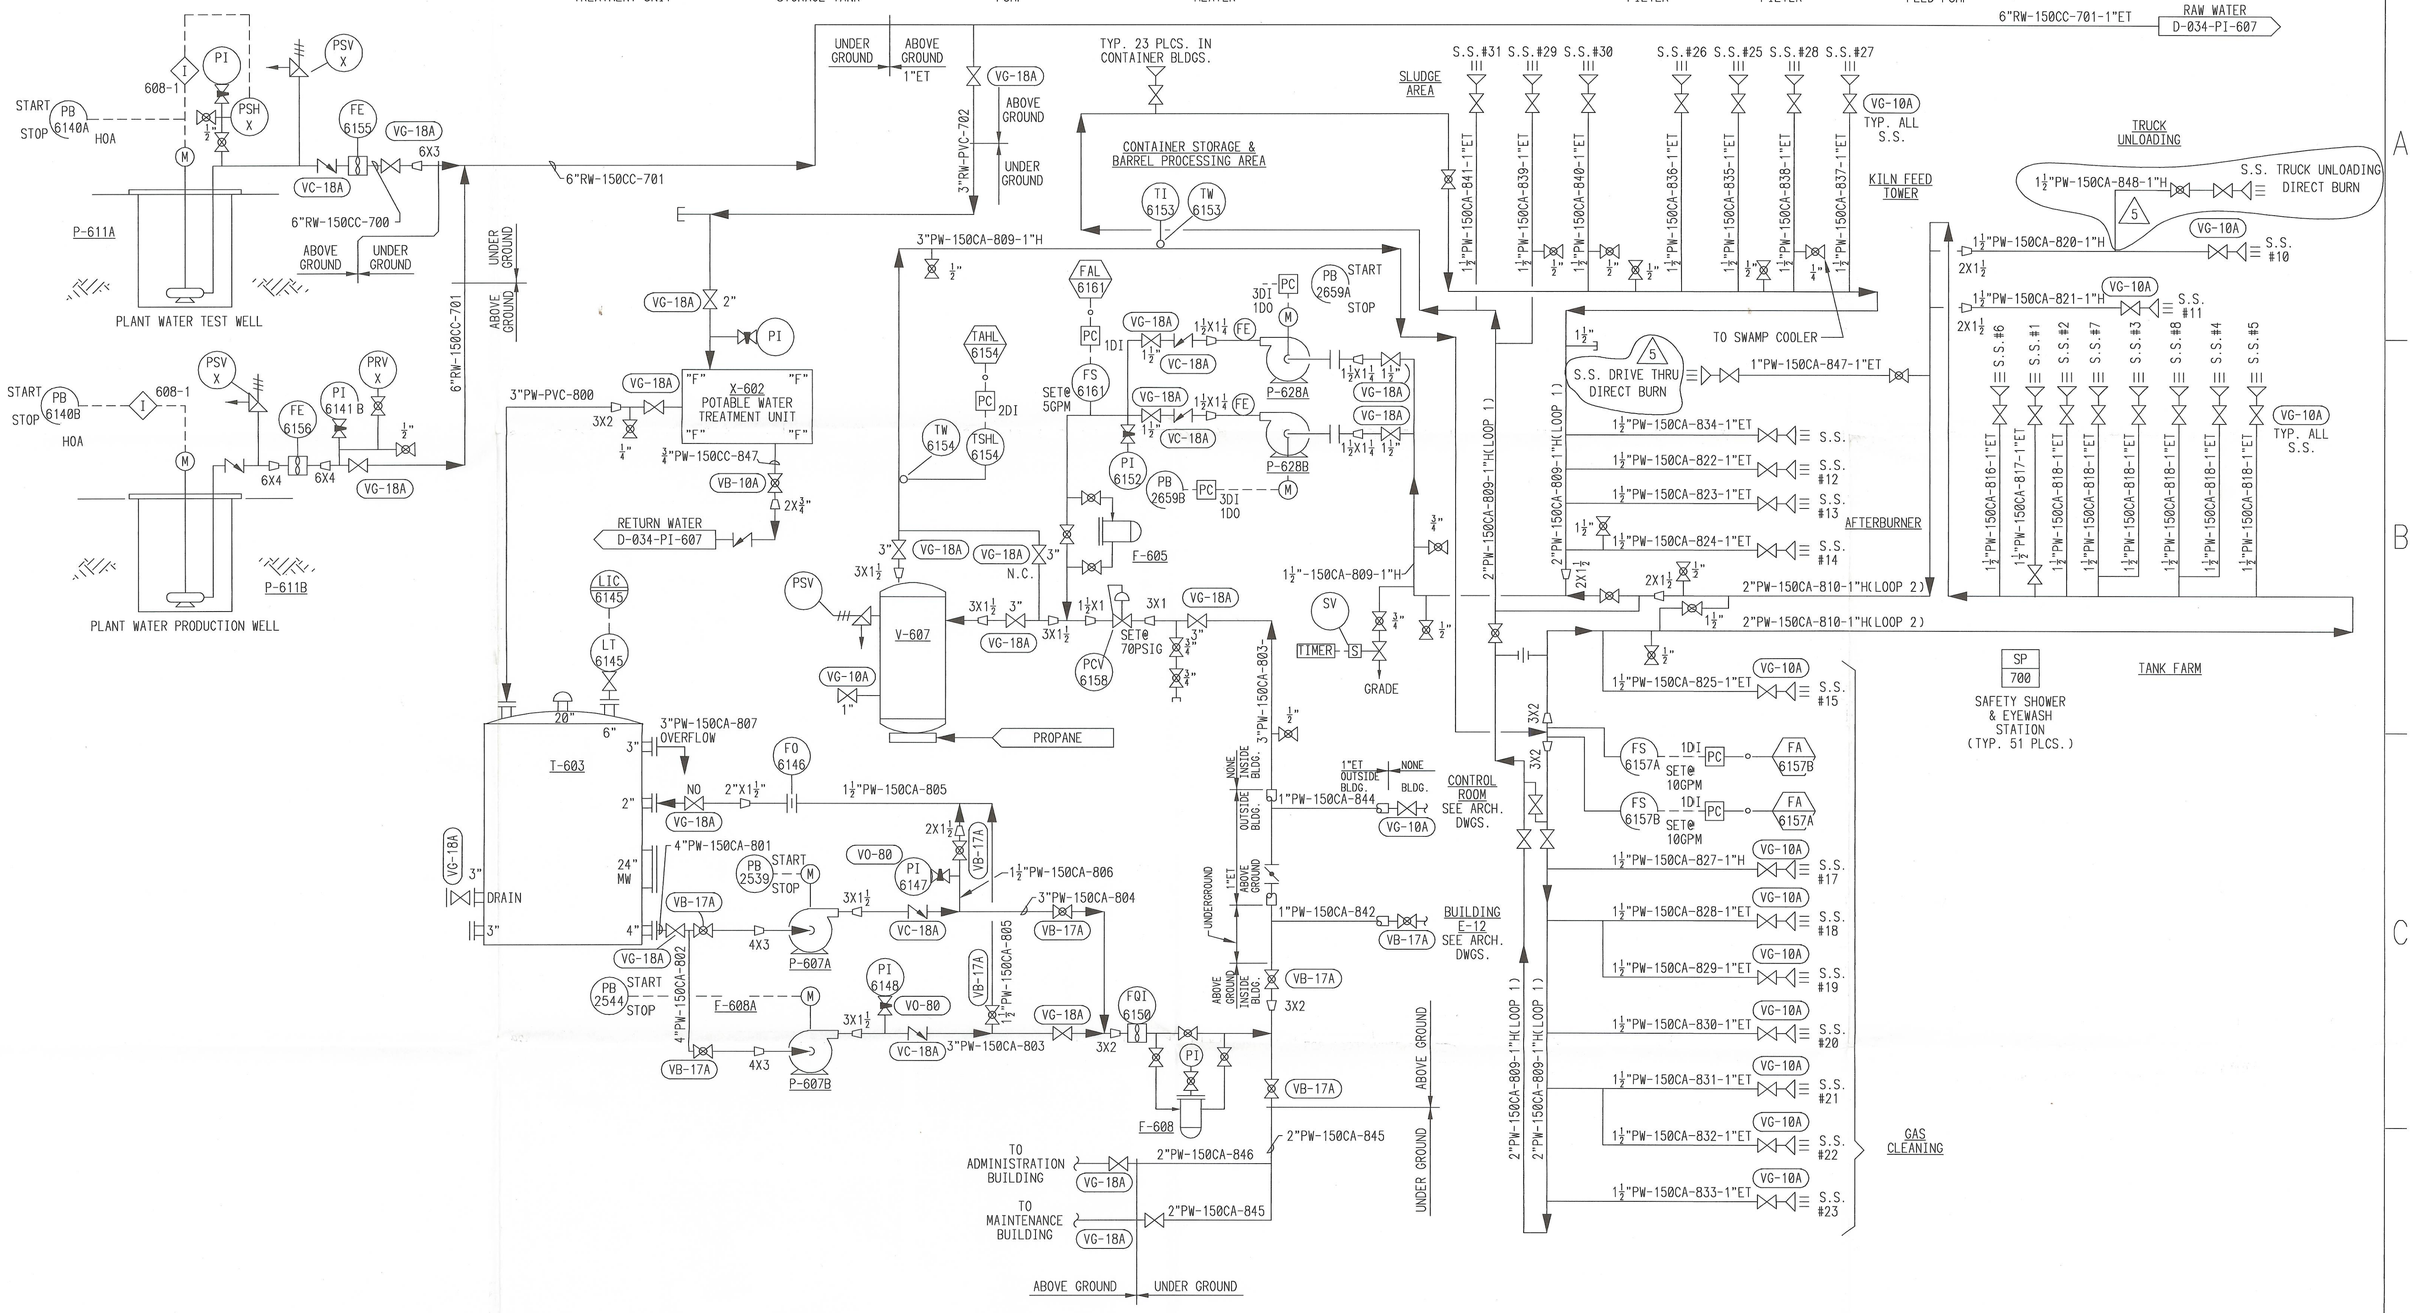

INTERLOCK DESCRIPTION

608-1 SHUTDOWN PUMP ON HIGH PRESSURE

REVISIONS

NO	DESCRIPTION	DATE	BY	CHK		ENG MGR
0	ISSUED FOR CONSTRUCTION	07-07-89	MU	IRB		JV
1	AS BUILT UPDATE	01-05-94	DCP			
2	TO CORRECT DRAFTING ERRORS	04-08-98	CRM			
3	AS BUILT	10-9-00	GVC			
4	ADDED SS TO DIRCT BURN TANKER AREA	3-6-01	GVC			

REVISIONS

NO	DESCRIPTION	DATE	BY	CHK		ENG MGR
5	ADDED S.S. TO TRUCK UNLOADING DIRECT BURN	03-19-02	KL			

APPROVALS

	BY	DATE
DRAWN	CRM	04-08-98
CHECKED		
ELEC		
MECH		
STRUCT		
PROJECT ENG		
ENGINEERING MGR		
AS BUILT		

REGISTERED PROFESSIONAL ENGINEER
No. 189797 LAYNE D. JENSEN
STATE OF UTAH
REGISTERED PROFESSIONAL ENGINEER
DATE: 4-11-02

safety-kleen
SAFETY-KLEEN (ARAGONITE), INC.
11600 NORTH APTUS ROAD, ARAGONITE, UT. 84029

TITLE
UTAH ENVIRONMENTAL SERVICE CENTER
INCINERATION PLANT FOR INDUSTRIAL WASTES
P&ID POTABLE WATER

FOR	CAD NO.	
TOOELE SITE	117821	
SCALE	JOB NO	APTUS DWG NO / REV
		D-034-PI-608 / 5