CAPACITIES (BY LOCATION)		
BUILDING OR BAY	55 GALLON CONTAINERS	GALLONS
BREEZEWAY	176	9,680
BREEZEWAY CONVEYOR	80	4,400
TRUCK UNLOADING (east bay)	144 or 1 tanker	7920 or 7500
TRUCK UNLOADING (center bay)	72 or 1 tanker	3960 or 7500
DIRECT BURN PAD	1 DBV	660
DRIVE THROUGH	12 and 2 tankers	15,000
DRUM PUMP STATION	4	220
BULK/SLUDGE PAD	144 or 6 rolloff boxes	7,920 or 23,760 if bulk containers
MAINTENANCE BAY PAD	24	1,320
CYLINDER FEED STATION	20	

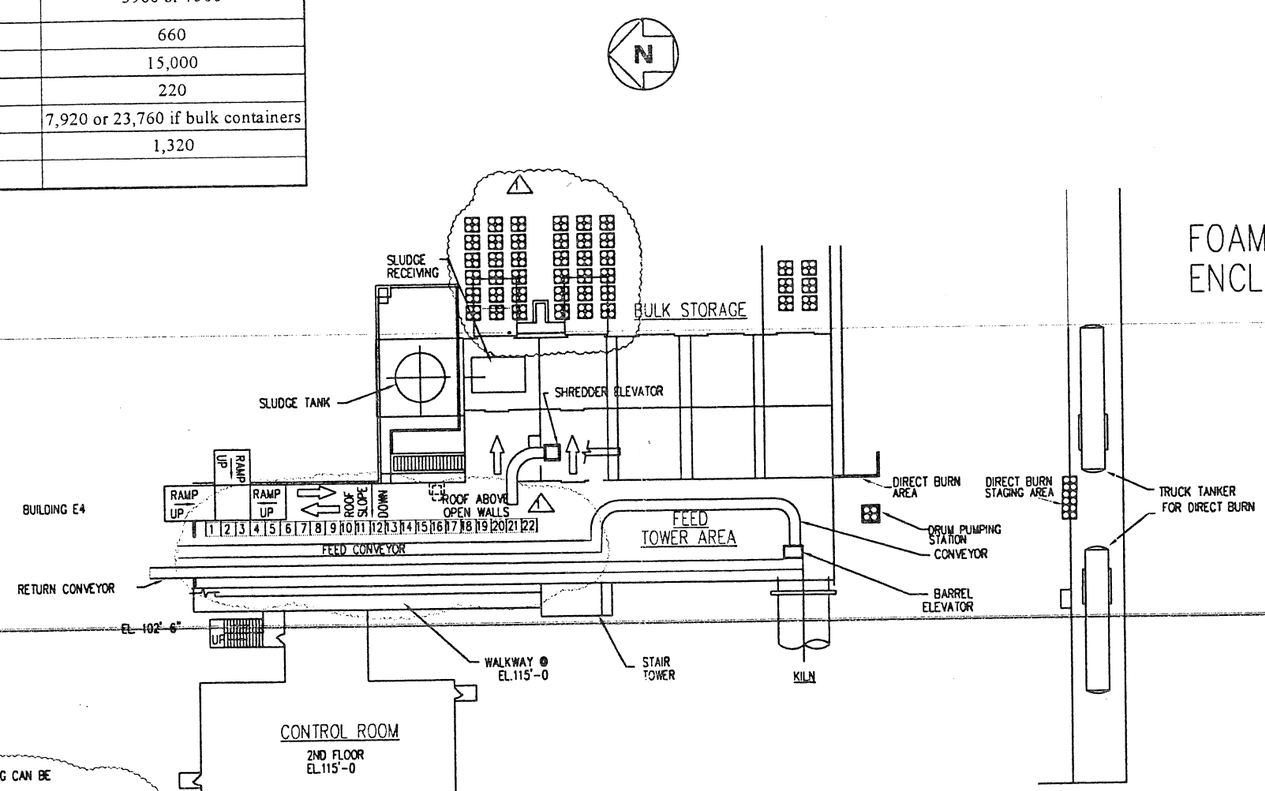

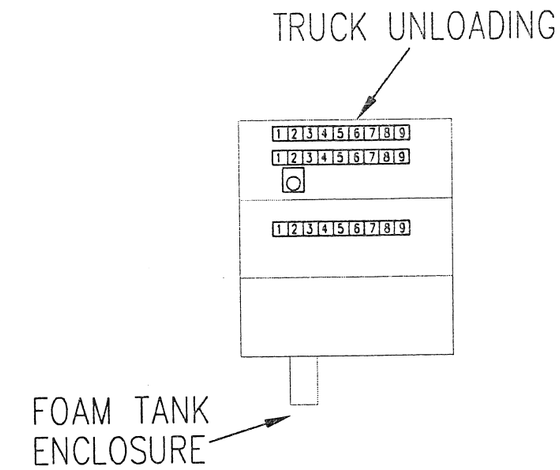

DESIGN CRITERIA:

1. 6" MINIMUM CURB AT EXTERIOR OPENINGS.
2. ALL CONVEYORS & DECANT STATIONS INSIDE CONTAINER PROCESSING BUILDING WILL BE FLOOR MOUNTED.
3. PALLETS ARE SHOWN FOR ILLUSTRATION ONLY.
4. EXITS PER U.B.C.
5. DIMENSIONS ARE NOMINAL INSIDE DIMENSIONS.
6. STORAGE ON BULK/SLUDGE PAD CAN BE TANKER, ROLLOFF BOX, OR DRUMS.
7. STORAGE IN TRUCKING UNLOADING CAN BE EITHER DRUMS OR BULK.
8. DRUM ROWS ON THE BULK SOLIDS AND SLUDGE PAD CAN BE MOVED SIDE TO SIDE ACROSS THE PAD TO ALLOW OFF LOADING INTO BINS.
9. BULK SOLIDS/SLUDGE PAD ARE SINGLE LEVEL.
10. BULK CONTAINERS MAY BE PLACED IN ANY OF THE ROWS ON THE BULK SOLIDS/SLUDGE PAD NOT TO EXCESS THE PERMITTED CAPACITY OF THE UNIT.

LICENSED PROFESSIONAL ENGINEER
KARL D. LIBSCH
No. 334380-2202
11/25/2007
STATE OF UTAH

SCALE
0 5 10 15 20 40 60
(FEET)
1"=20'-0

REFERENCE DRAWINGS	
DRAWING NO	TITLE

REVISIONS						
NO	DESCRIPTION	DATE	BY	CHK		ENG MGR
1	RECOVERED AND ADDED STORAGE	09-25-06	JM			

REVISIONS						
NO	DESCRIPTION	DATE	BY	CHK		ENG MGR

APPROVALS	BY	DATE
DRAWN	DCF	04-25-95
CHECKED		
ELEC		
MECH		
STRUCT		
PROJECT ENG		
ENGINEERING MGR		
AS BUILT		

REGISTERED PROFESSIONAL ENGINEER
DATE: _____

CleanHarbors
ARGONITE LLC

TITLE
UTAH ENVIRONMENTAL SERVICE CENTER
INCINERATION PLANT FOR INDUSTRIAL WASTES
MATERIAL HANDLING AREA PLAN

FOR TOOELE SITE
CAD NO. M4301A
SCALE 1"= 20'-0"
JOB NO
SAFETY-KLEEN DWG NO D-800-M-403
REV 1