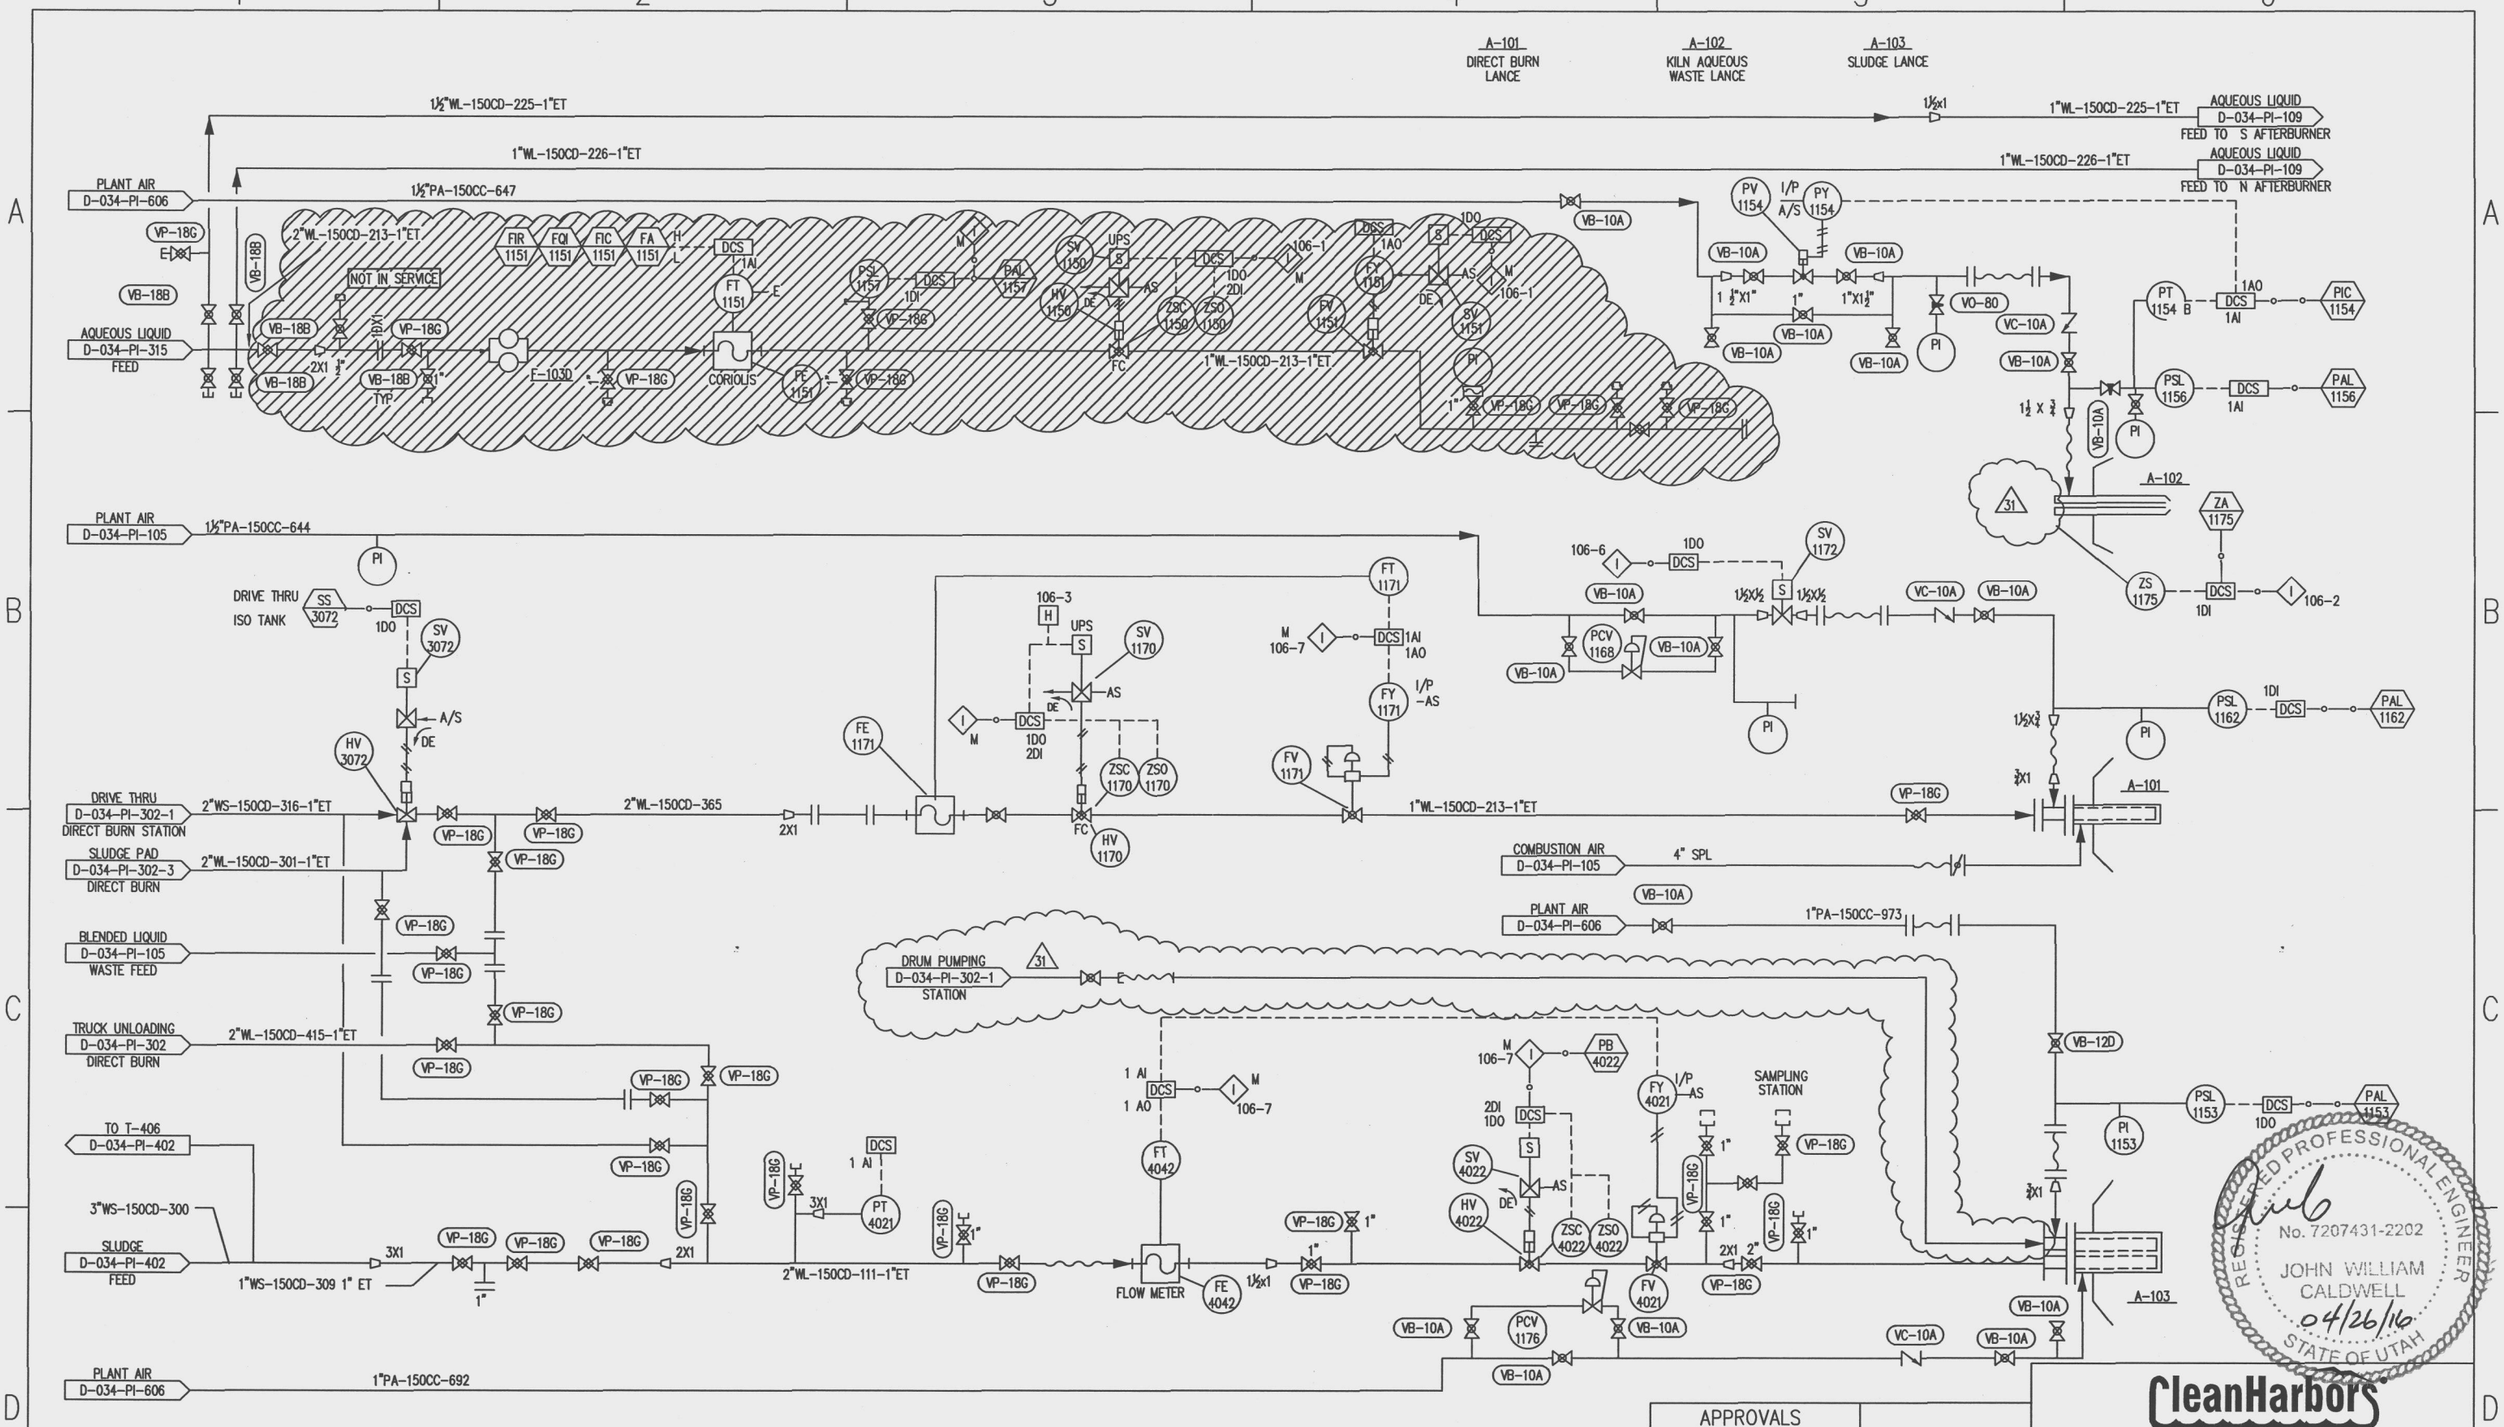

INTERLOCK DESCRIPTION

M MASTER INTERLOCK SYSTEM; DWG'S D-034-PI-003 & 004
106-1 VALVE CLOSED OR MIN. FIRE BEFORE BLOCK VALVE CAN OPEN
106-2 LANCE IN POSITION BEFORE VALVE CAN OPEN
106-3 HARDWIRE INTERLOCK TO BMS

106-5 RESERVED
106-6 SV TO OPEN WHEN SV1170 IS OPEN
106-7 VALVE CLOSED ON INTERLOCK

REVISIONS

NO	DESCRIPTION	DATE	BY	CHK		ENG MGR
21	CORRECTIONS, LINE MOVED TO A-103 NOZZLE	04-22-2016	MM	LB		
22	REMOVE NITROGEN SYSTEM	05-07-02	KL			
23	REMOVED SWITCHING POTS	05-14-02	LC			
24	ADDED DRUM DIRECT BURN LINE	6-26-03	KL			
25	SLUDGE NOZZLE ONLY	11-13-03	KL			

REVISIONS

NO	DESCRIPTION	DATE	BY	CHK		ENG MGR
26	AS BUILT	05-23-06	KL			
27	ADDED DUAL NOZZEL AT SLUDGE PORT	6-01-2010	LCC			
28	PIPING MODS FOR ISO TANKER	10-28-2011	LCC			
29	MOVED DRUM PUMP TO A-102	04-18-2012	LCC			
30	ADDED SLUDGE PAD DIRECT BURN LINE	11-17-15	MM	LB		

APPROVALS

	BY	DATE
DRAWN	CRM	06-20-97
CHECKED		
ELEC		
MECH		
STRUCT		
PROJECT ENG		
ENGINEERING MGR		
AS BUILT		

REGISTERED PROFESSIONAL ENGINEER
DATE:_____

REGISTERED PROFESSIONAL ENGINEER
No. 7207431-2202
JOHN WILLIAM CALDWELL
04/26/16
STATE OF UTAH

CleanHarbors
ARAGONITE LLC

THIS DRAWING IS THE PROPERTY OF CLEAN HARBORS ARAGONITE LLC
ANY INFORMATION CONTAINED HEREON MAY NOT BE COPIED
OR USED WITHOUT WRITTEN PERMISSION OF OWNER.

TITLE
UTAH ENVIRONMENTAL SERVICE CENTER
INCINERATION PLANT FOR INDUSTRIAL WASTES
P&ID FRONT WALL BURNER CONTROLS SHEET 2

FOR	CAD NO.	
TOOELE SITE	IH770	
SCALE: NA	JOB NO	SAFETY-KLEEN DWG NO: D-034-PI-106	REV: 31